


WARNING
BEWARE OF NEW AND EXISTING UNDERGROUND SERVICES
 THE LOCATIONS OF NEW AND EXISTING UNDERGROUND SERVICES ARE APPROXIMATE ONLY AND THEIR EXACT POSITION SHOULD BE PROVEN ON SITE. NO GUARANTEE IS GIVEN THAT ALL EXISTING SERVICES ARE SHOWN. IT IS THE CONTRACTORS RESPONSIBILITY TO VERIFY LOCATION AND DEPTH OF ALL NEW AND EXISTING UNDERGROUND SERVICES PRIOR TO CONSTRUCTION WORK. THE CONTRACTOR SHALL VISIT THE SITE TO ASCERTAIN THE TRUE NATURE OF THE WORKS. NO CLAIMS FOR EXTRAS WILL BE ALLOWED FOR THROUGH NEGLIGENCE OF THIS ADVICE. COORDINATE INVERT LEVEL AND LOCATION OF NEW AND EXISTING SERVICES TO AVOID CLASHES WITH STRUCTURAL ELEMENTS AND OTHER SERVICES OF OTHER TRADES BEFORE COMMENCING ANY WORK ON SITE.


- NOTES:**
- THIS DRAWING SHALL BE READ IN CONJUNCTION WITH THE ELECTRICAL SERVICES SPECIFICATION NOTES, THE ARCHITECTURAL DRAWINGS AND ALL OTHER RELEVANT SERVICES DRAWINGS.
 - REFER TO EL-0-01 FOR LEGEND, GENERAL NOTES AND LIGHT FITTING SCHEDULE.
 - POWER AND COMMUNICATION CONDUITS SHALL BE BORED. ENSURE THAT THE MINIMUM REQUIRED CLEARANCE IS MAINTAINED BETWEEN SERVICES.
 - CABLE PITS WITHIN PATHWAYS SHALL BE FINISHED FLUSH WITH THE FINISHED LEVEL OF THE IN-SITU CONCRETE, PAVING OR BITUMEN.
 - ALL CONDUITS SHALL BE SEALED TO PREVENT THE INGRESS OF WATER AFTER INSTALLATION OF CABLING.
 - ALL EQUIPMENT AND ACCESSORIES SHALL BE NEW UNLESS NOTED OTHERWISE.
 - THE ELECTRICAL EQUIPMENT SHOWN ON THE DRAWINGS ARE NOT TO SCALE. FINAL POSITION OF ALL EQUIPMENT TO BE DETERMINED ON SITE PRIOR TO INSTALLATION. REFER TO ARCHITECTURAL FITOUT DRAWINGS.
 - CONDUIT SIZE SHOWN IS REPRESENTATIVE OF THE MINIMUM REQUIREMENT. THE CONTRACTOR MUST SIZE UP TO SUIT THE FINAL CABLE SIZE.
 - CONTRACTOR SHALL ENGAGE WITH TREE ARBORIST TO VALIDATE TPZ (TREE PROTECTION ZONES) WHERE CONDUITS ARE INSTALLED IN CLOSE PROXIMITY AND ADEQUATE PROTECTION SHALL BE PROVIDED TO PREVENT UNDUE DAMAGE TO CONDUITS. EXACT FINAL CONDUIT ROUTES WOULD BE SUBJECT TO SATISFYING ARBORIST REQUIREMENTS.
 - CONTRACTOR SHALL RUN CONDUIT CLOSE TO PATHWAY EDGE. THE CONDUIT RUN DRAWN HERE IS ONLY INDICATIVE. CONTRACTOR TO CONSIDER 500mm BACK OF PATH IN ADDITION TO ABOVE.
 - PROJECT ARBORIST WILL REVIEW ON SITE ALL NEW POLE LOCATIONS SHOWN. DIRECTIONAL BORING FOR UNDERGROUND CONDUITS IS TO OCCUR AT 1000MM DEPTH.

FOR CONTINUATION REFER TO DRAWING EL-2-09 (ZONE 5 - SHEET 2)

FOR CONTINUATION REFER TO DRAWING EL-2-07 (ZONE 4 - SHEET 2)

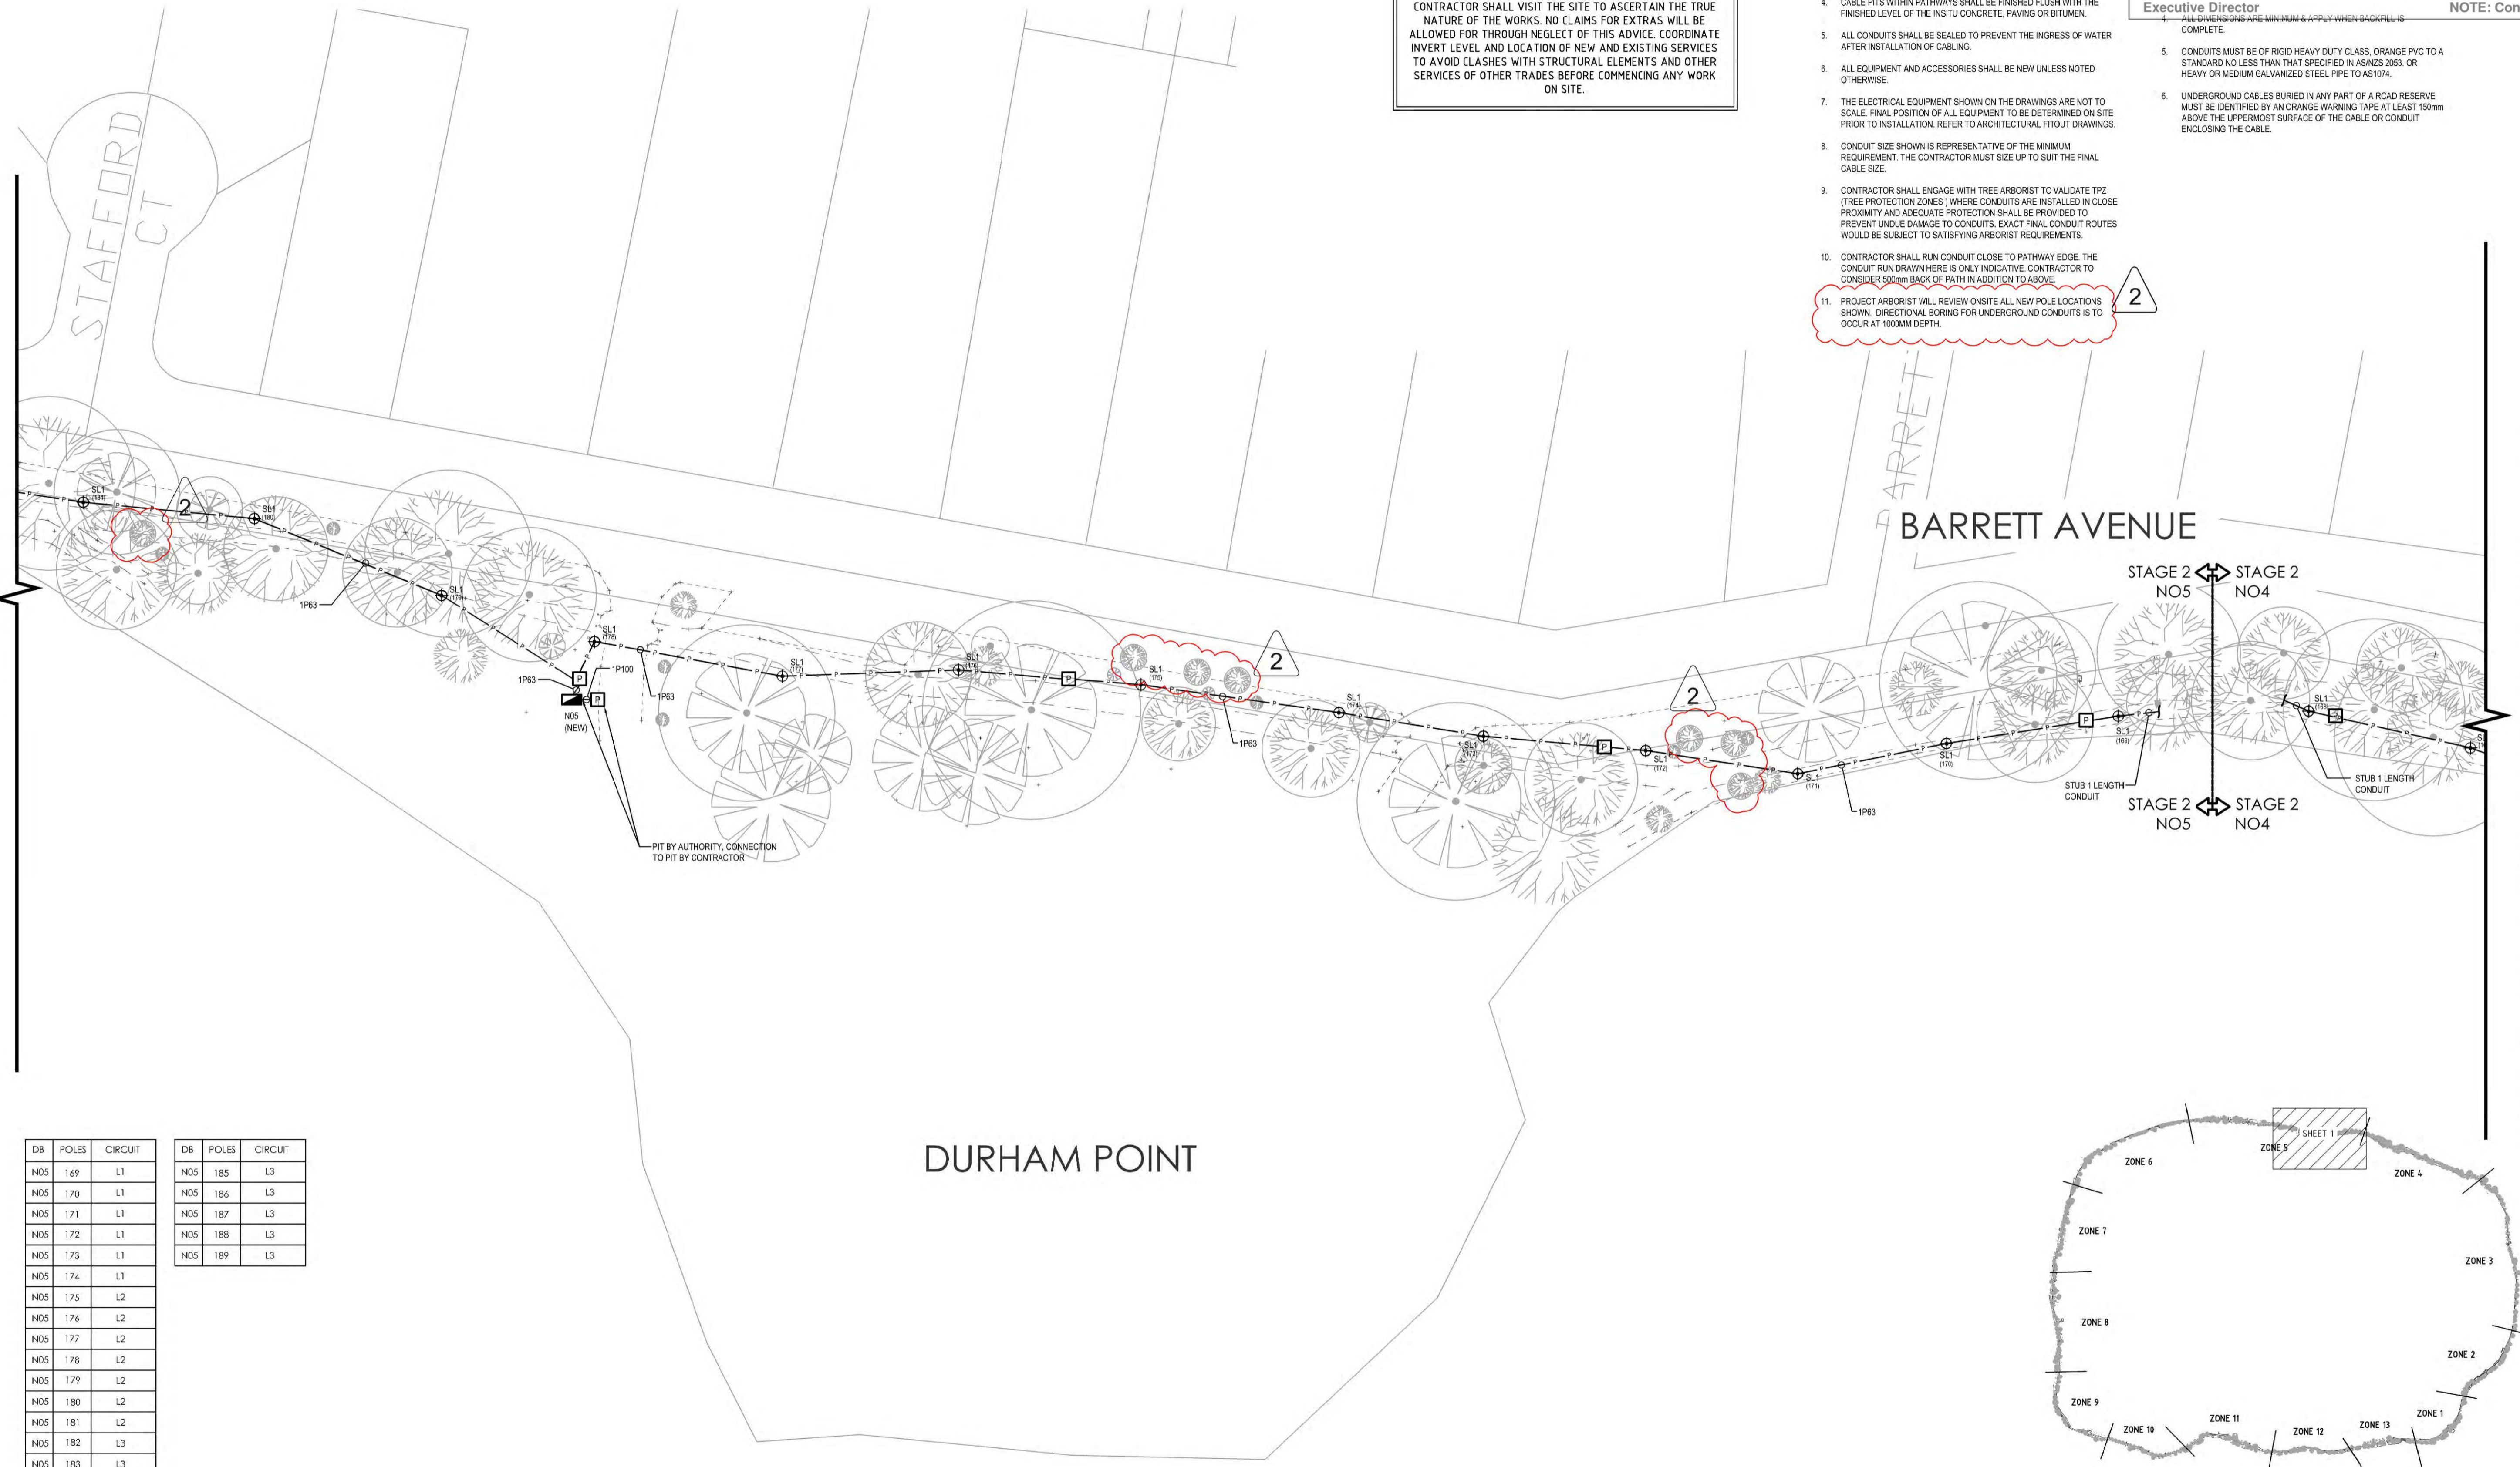

DB	POLES	CIRCUIT	DB	POLES	CIRCUIT
NOS	169	L1	NOS	185	L3
NOS	170	L1	NOS	186	L3
NOS	171	L1	NOS	187	L3
NOS	172	L1	NOS	188	L3
NOS	173	L1	NOS	189	L3
NOS	174	L1			
NOS	175	L2			
NOS	176	L2			
NOS	177	L2			
NOS	178	L2			
NOS	179	L2			
NOS	180	L2			
NOS	181	L2			
NOS	182	L3			
NOS	183	L3			
NOS	184	L3			

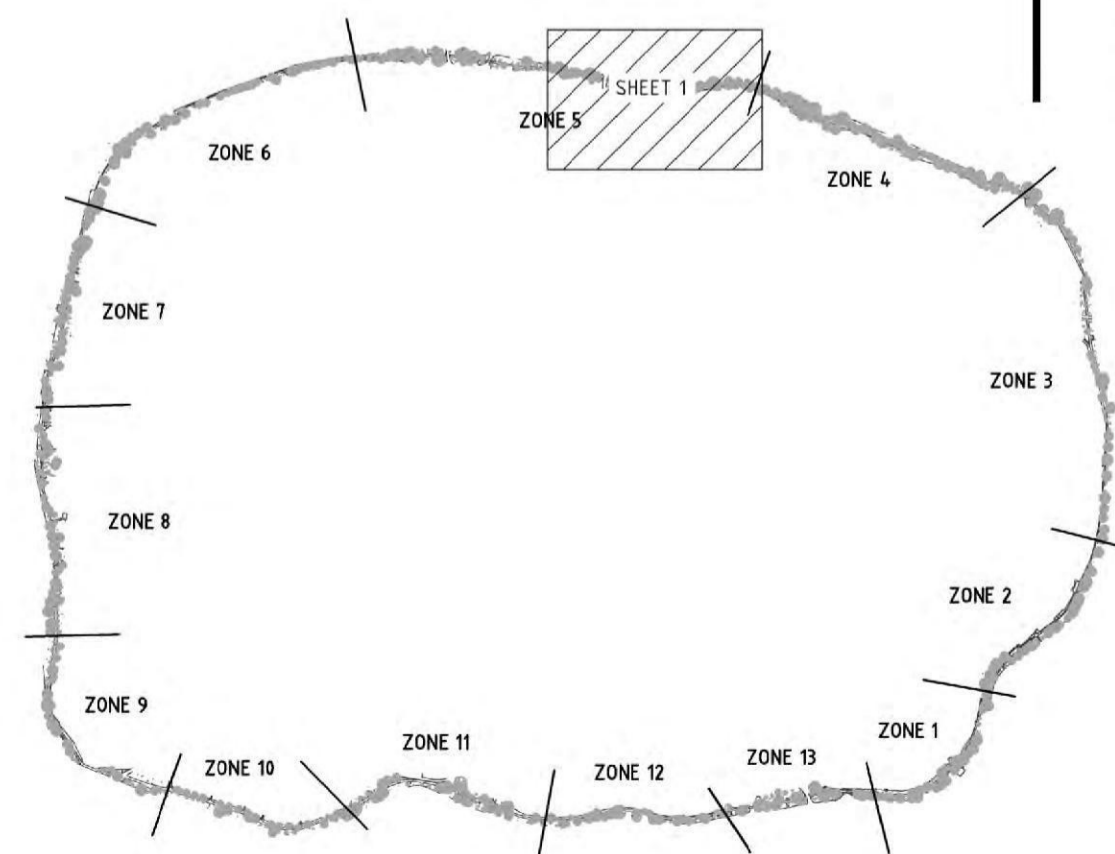

REV	DESCRIPTION	DRAWN	APPD	DATE
2	ISSUED FOR CONSTRUCTION	TRS	JPK	07.06.22
1	ISSUED FOR CONSTRUCTION	TRS	JPK	13.04.22

REPRODUCTION OF DRAWINGS
 THE DRAWINGS HAVE BEEN DOCUMENTED IN COLOUR. AS SUCH, THE DRAWINGS ARE REQUIRED TO BE PRINTED IN COLOUR. FAILURE TO DO SO MAY RESULT IN LOSS OF INFORMATION. BLACK & WHITE PRINTING MAY BE USED IF SPECIFIC BLACK & WHITE DOCUMENTS HAVE BEEN OBTAINED FROM WGE.

ARCHITECT/CIENT

LAKE WENDOUREE, BALLARAT, STEVE MONEGHETTI TRACK
 PUBLIC LIGHTING

ZONE 5 - PROPOSED LIGHTING & POWER LAYOUT - STAGE 2 SHEET 1

PROJECT TITLE

45683-EL-2-08.dwg

CONSTRUCTION ISSUE

Stantec

ELECTRICAL SERVICES

1:500 45683 EL-2-08 2

SCALE @ A1 PROJECT No DRAWING No REV


7/06/2022 4:48:39 PM

WARNING
 BEWARE OF NEW AND EXISTING UNDERGROUND SERVICES
 THE LOCATIONS OF NEW AND EXISTING UNDERGROUND SERVICES ARE APPROXIMATE ONLY AND THEIR EXACT POSITION SHOULD BE PROVEN ON SITE. NO GUARANTEE IS GIVEN THAT ALL EXISTING SERVICES ARE SHOWN. IT IS THE CONTRACTORS RESPONSIBILITY TO VERIFY LOCATION AND DEPTH OF ALL NEW AND EXISTING UNDERGROUND SERVICES PRIOR TO CONSTRUCTION WORK. THE CONTRACTOR SHALL VISIT THE SITE TO ASCERTAIN THE TRUE NATURE OF THE WORKS. NO CLAIMS FOR EXTRAS WILL BE ALLOWED FOR THROUGH NEGLIGENCE OF THIS ADVICE. COORDINATE INVERT LEVEL AND LOCATION OF NEW AND EXISTING SERVICES TO AVOID CLASHES WITH STRUCTURAL ELEMENTS AND OTHER SERVICES OF OTHER TRADES BEFORE COMMENCING ANY WORK ON SITE.


- NOTES:**
- THIS DRAWING SHALL BE READ IN CONJUNCTION WITH THE ELECTRICAL SERVICES SPECIFICATION NOTES, THE ARCHITECTURAL DRAWINGS AND ALL OTHER RELEVANT SERVICES DRAWINGS.
 - REFER TO EL-0-01 FOR LEGEND, GENERAL NOTES AND LIGHT FITTING SCHEDULE.
 - POWER AND COMMUNICATION CONDUITS SHALL BE BORED. ENSURE THAT THE MINIMUM REQUIRED CLEARANCE IS MAINTAINED BETWEEN SERVICES.
 - CABLE PITS WITHIN PATHWAYS SHALL BE FINISHED FLUSH WITH THE FINISHED LEVEL OF THE INSTANT CONCRETE, PAVING OR BITUMEN.
 - ALL CONDUITS SHALL BE SEALED TO PREVENT THE INGRESS OF WATER AFTER INSTALLATION OF CABLING.
 - ALL EQUIPMENT AND ACCESSORIES SHALL BE NEW UNLESS NOTED OTHERWISE.
 - THE ELECTRICAL EQUIPMENT SHOWN ON THE DRAWINGS ARE NOT TO SCALE. FINAL POSITION OF ALL EQUIPMENT TO BE DETERMINED ON SITE PRIOR TO INSTALLATION. REFER TO ARCHITECTURAL FITOUT DRAWINGS.
 - CONDUIT SIZE SHOWN IS REPRESENTATIVE OF THE MINIMUM REQUIREMENT. THE CONTRACTOR MUST SIZE UP TO SUIT THE FINAL CABLE SIZE.
 - CONTRACTOR SHALL ENGAGE WITH TREE ARBORIST TO VALIDATE TPZ (TREE PROTECTION ZONES) WHERE CONDUITS ARE INSTALLED IN CLOSE PROXIMITY AND ADEQUATE PROTECTION SHALL BE PROVIDED TO PREVENT UNDESTRUCTIVE DAMAGE TO CONDUITS. EXACT FINAL CONDUIT ROUTES WOULD BE SUBJECT TO SATISFYING ARBORIST REQUIREMENTS.
 - CONTRACTOR SHALL RUN CONDUIT CLOSE TO PATHWAY EDGE. THE CONDUIT RUN DRAWN HERE IS ONLY INDICATIVE. CONTRACTOR TO CONSIDER 500mm BACK OF PATH IN ADDITION TO ABOVE.
 - PROJECT ARBORIST WILL REVIEW ON SITE ALL NEW POLE LOCATIONS SHOWN. DIRECTIONAL BORING FOR UNDERGROUND CONDUITS IS TO OCCUR AT 1000MM DEPTH.

FOR CONTINUATION REFER TO DRAWING EL-2-10 (ZONE 6 - SHEET 1)

FOR CONTINUATION REFER TO DRAWING EL-2-08 (ZONE 5 - SHEET 1)

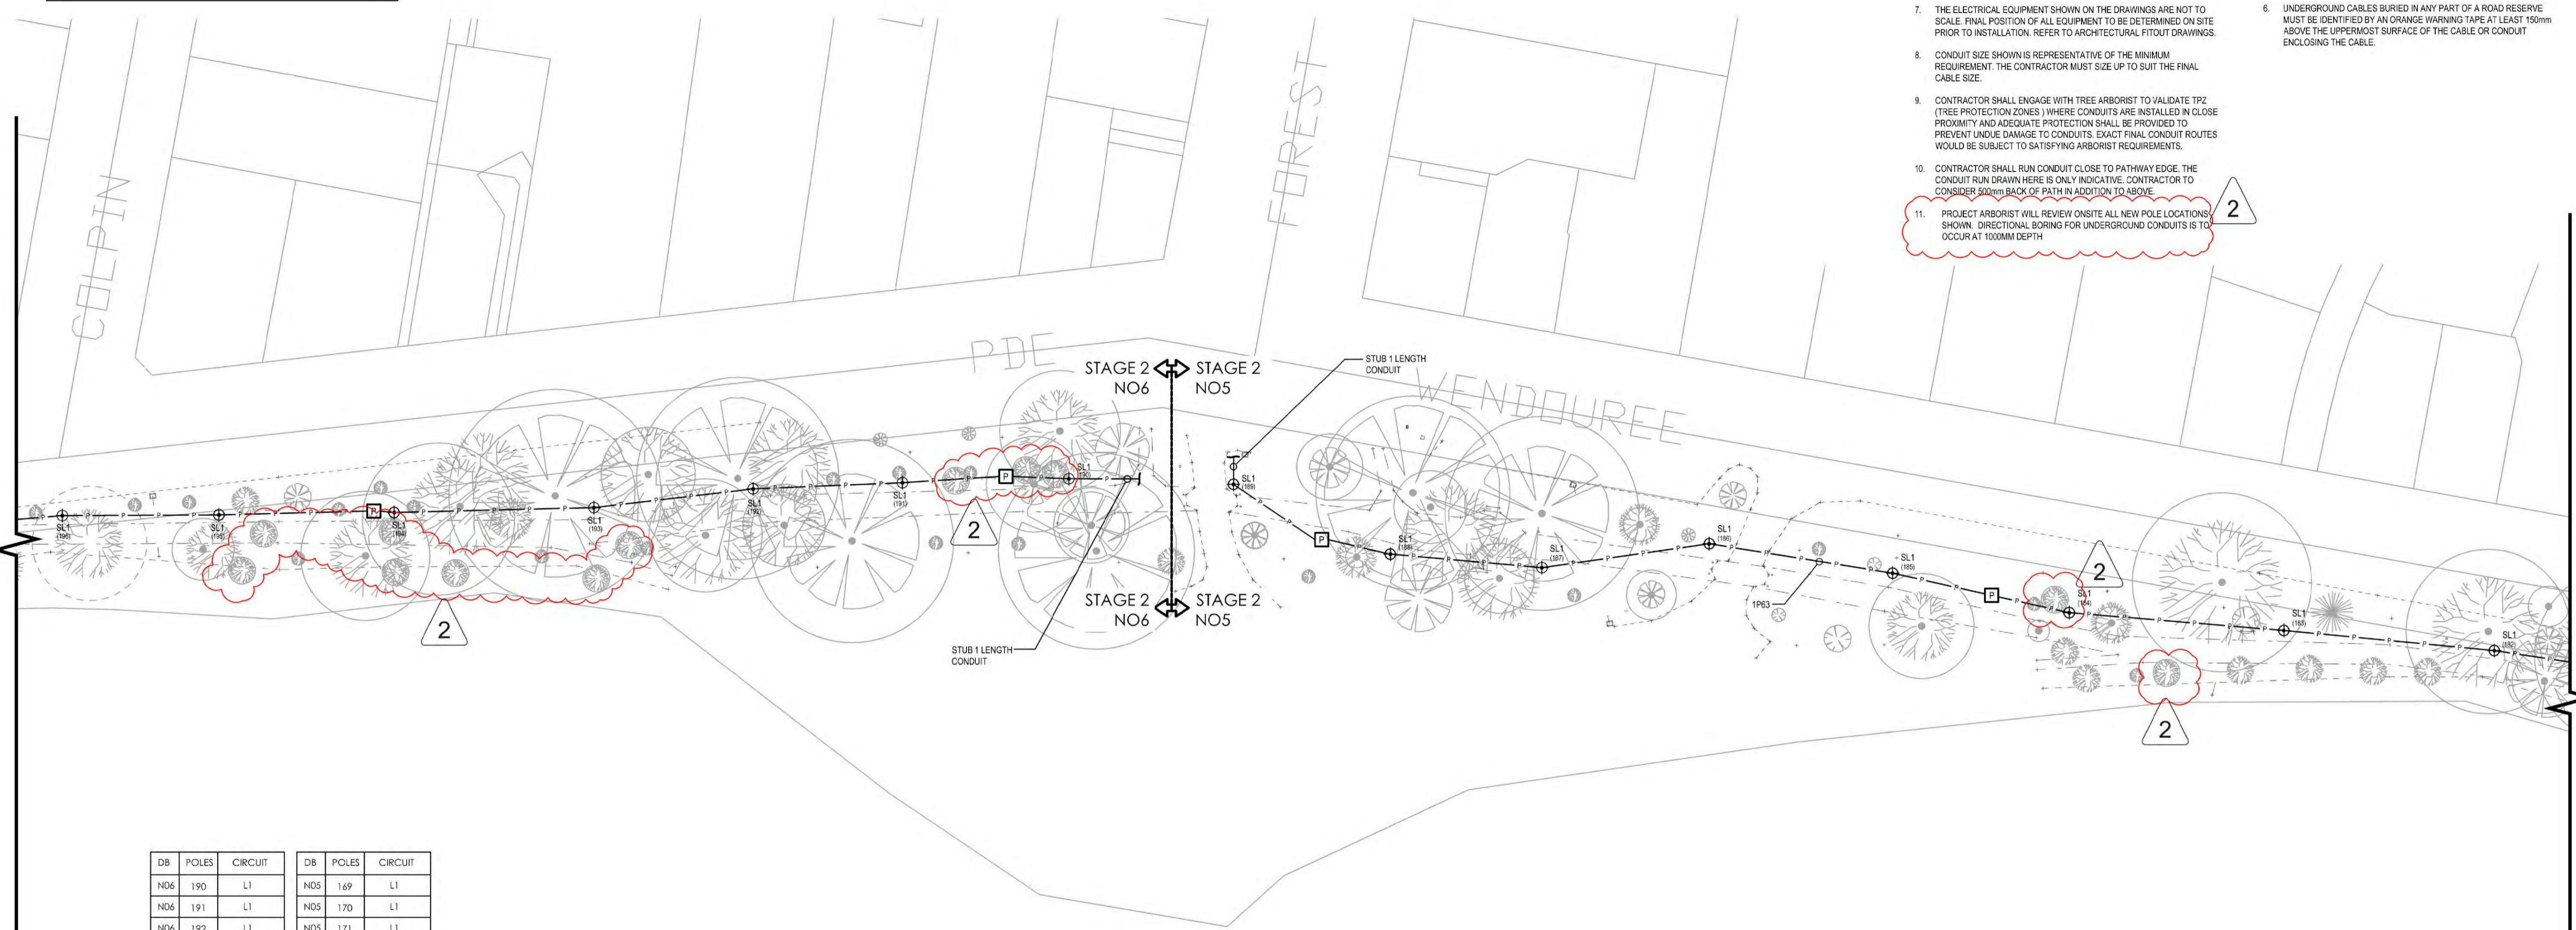

DB	POLES	CIRCUIT	DB	POLES	CIRCUIT
ND6	190	L1	ND5	169	L1
ND6	191	L1	ND5	170	L1
ND6	192	L1	ND5	171	L1
ND6	193	L1	ND5	172	L1
ND6	194	L1	ND5	173	L1
ND6	195	L1	ND5	174	L1
ND6	196	L2	ND5	175	L2
ND6	197	L2	ND5	176	L2
ND6	198	L2	ND5	177	L2
ND6	199	L2	ND5	178	L2
ND6	200	L2	ND5	179	L2
ND6	201	L2	ND5	180	L2
ND6	202	L2	ND5	181	L2
ND6	203	L3	ND5	182	L3
ND6	204	L3	ND5	183	L3
ND6	205	L3	ND5	184	L3
ND6	206	L3	ND5	185	L3
ND6	207	L3	ND5	186	L3
ND6	208	L3	ND5	187	L3
ND6	209	L3	ND5	188	L3
ND6	210	L3	ND5	189	L3

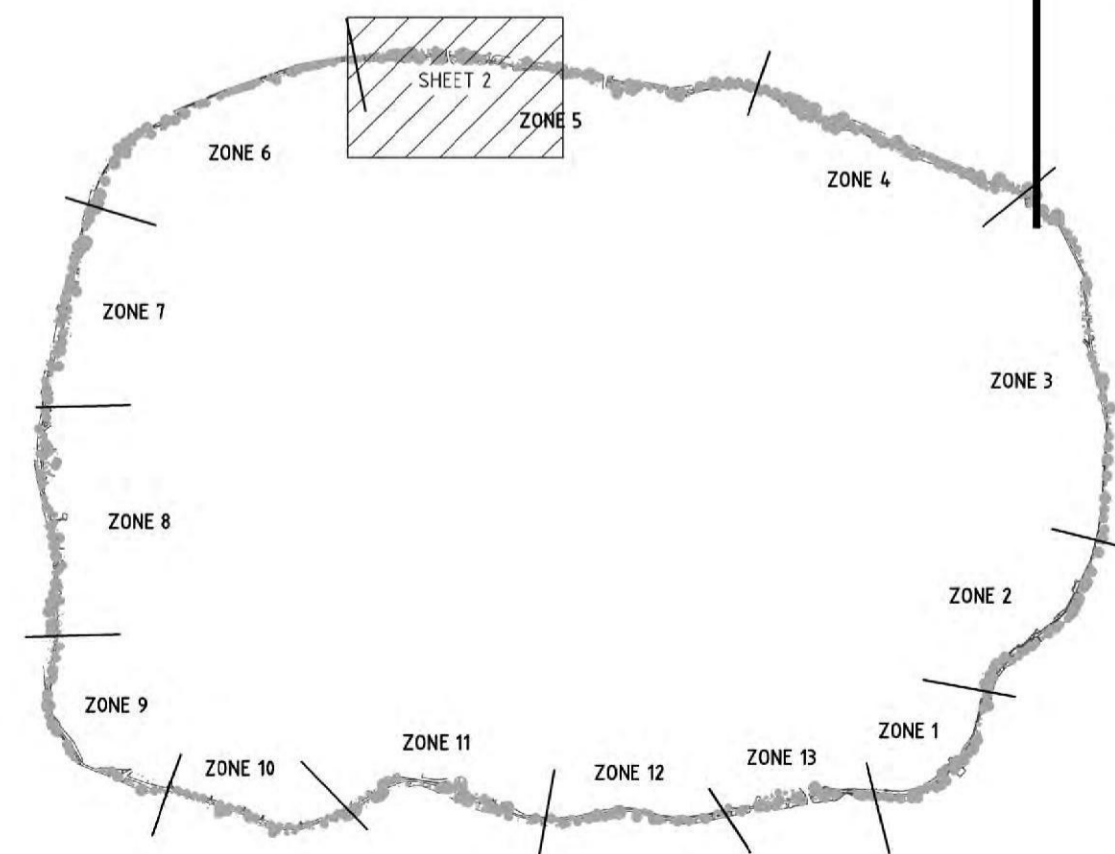

KEY PLAN

REV	DESCRIPTION	DRAWN	APPD	DATE
2	ISSUED FOR CONSTRUCTION	TRS	JPK	07.06.22
1	ISSUED FOR CONSTRUCTION	TRS	JPK	13.04.22

REPRODUCTION OF DRAWINGS
 THE DRAWINGS HAVE BEEN DOCUMENTED IN COLOUR. AS SUCH, THE DRAWINGS ARE REQUIRED TO BE PRINTED IN COLOUR. FAILURE TO DO SO MAY RESULT IN LOSS OF INFORMATION. BLACK & WHITE PRINTING MAY BE USED IF SPECIFIC BLACK & WHITE DOCUMENTS HAVE BEEN OBTAINED FROM WGE.

ARCHITECT/CIENT

LAKE WENDOUREE, BALLARAT, STEVE MONEGHETTI TRACK
 PUBLIC LIGHTING

ZONE 5 - PROPOSED LIGHTING & POWER LAYOUT - STAGE 2 SHEET 2

PROJECT TITLE

Stantec CONSTRUCTION ISSUE
 ELECTRICAL SERVICES

1:500 45683 EL-2-09 2
 SCALE @ A1 PROJECT No DRAWING No REV


NOTES

- THIS DRAWING SHALL BE READ IN CONJUNCTION WITH THE ELECTRICAL SERVICES SPECIFICATION NOTES, THE ARCHITECTURAL DRAWINGS AND ALL OTHER RELEVANT SERVICES DRAWINGS.
- REFER TO EL-0-01 FOR LEGEND, GENERAL NOTES AND LIGHT FITTING SCHEDULE.
- POWER AND COMMUNICATION CONDUITS SHALL BE BORED. ENSURE THAT THE MINIMUM REQUIRED CLEARANCE IS MAINTAINED BETWEEN SERVICES.
- CABLE PITS WITHIN PATHWAYS SHALL BE FINISHED FLUSH WITH THE FINISHED LEVEL OF THE INSITU CONCRETE, PAVING OR BITUMEN.
- ALL CONDUITS SHALL BE SEALED TO PREVENT THE INGRESS OF WATER AFTER INSTALLATION OF CABLING.
- ALL EQUIPMENT AND ACCESSORIES SHALL BE NEW UNLESS NOTED OTHERWISE.
- THE ELECTRICAL EQUIPMENT SHOWN ON THE DRAWINGS ARE NOT TO SCALE. FINAL POSITION OF ALL EQUIPMENT TO BE DETERMINED ON SITE PRIOR TO INSTALLATION. REFER TO ARCHITECTURAL FITOUT DRAWINGS.
- CONDUIT SIZE SHOWN IS REPRESENTATIVE OF THE MINIMUM REQUIREMENT. THE CONTRACTOR MUST SIZE UP TO SUIT THE FINAL CABLE SIZE.
- CONTRACTOR SHALL ENGAGE WITH TREE ARBORIST TO VALIDATE TPZ (TREE PROTECTION ZONES) WHERE CONDUITS ARE INSTALLED IN CLOSE PROXIMITY AND ADEQUATE PROTECTION SHALL BE PROVIDED TO PREVENT UNDUE DAMAGE TO CONDUITS. EXACT FINAL CONDUIT ROUTES WOULD BE SUBJECT TO SATISFYING ARBORIST REQUIREMENTS.
- CONTRACTOR SHALL RUN CONDUIT CLOSE TO PATHWAY EDGE. THE CONDUIT RUN DRAWN HERE IS ONLY INDICATIVE. CONTRACTOR TO CONSIDER 500mm BACK OF PATH IN ADDITION TO ABOVE.
- PROJECT ARBORIST WILL REVIEW ONSITE ALL NEW POLE LOCATIONS SHOWN. DIRECTIONAL BORING FOR UNDERGROUND CONDUITS IS TO OCCUR AT 1000MM DEPTH.

UNDERGROUND SERVICES NOTES

- SAND IS TO BE USED ONLY IF THE SOIL EXCAVATED IS, IN THE OPINION OF THE RESPONSIBLE OFFICER, UNSUITABLE FOR BEDDING & SCREENING OF THE CABLES.
- ALL OTHER DEPTH OF TRENCH IS TO BE BACKFILLED WITH EXCAVATED MATERIAL. UNLESS OTHERWISE DIRECTED BY THE RESPONSIBLE OFFICER, BACKFILL TO BE COMPACTED & GIVEN TIME TO SETTLE BEFORE REINSTATEMENT OF THE ASPHALT.
- SEPARATION BETWEEN LOW VOLTAGE MAINS CABLES SHOULD BE 50mm.
- ALL DIMENSIONS ARE MINIMUM & APPLY WHEN BACKFILL IS COMPLETE.
- CONDUITS MUST BE OF RIGID HEAVY DUTY CLASS, ORANGE PVC TO A STANDARD NO LESS THAN THAT SPECIFIED IN AS/NZS 2053, OR HEAVY OR MEDIUM GALVANIZED STEEL PIPE TO AS1074.
- UNDERGROUND CABLES BURIED IN ANY PART OF A ROAD RESERVE MUST BE IDENTIFIED BY AN ORANGE WARNING TAPE AT LEAST 150mm ABOVE THE UPPERMOST SURFACE OF THE CABLE OR CONDUIT ENCLOSING THE CABLE.

FOR CONTINUATION REFER TO DRAWING EL-2-11 (ZONE 6 - SHEET 2)

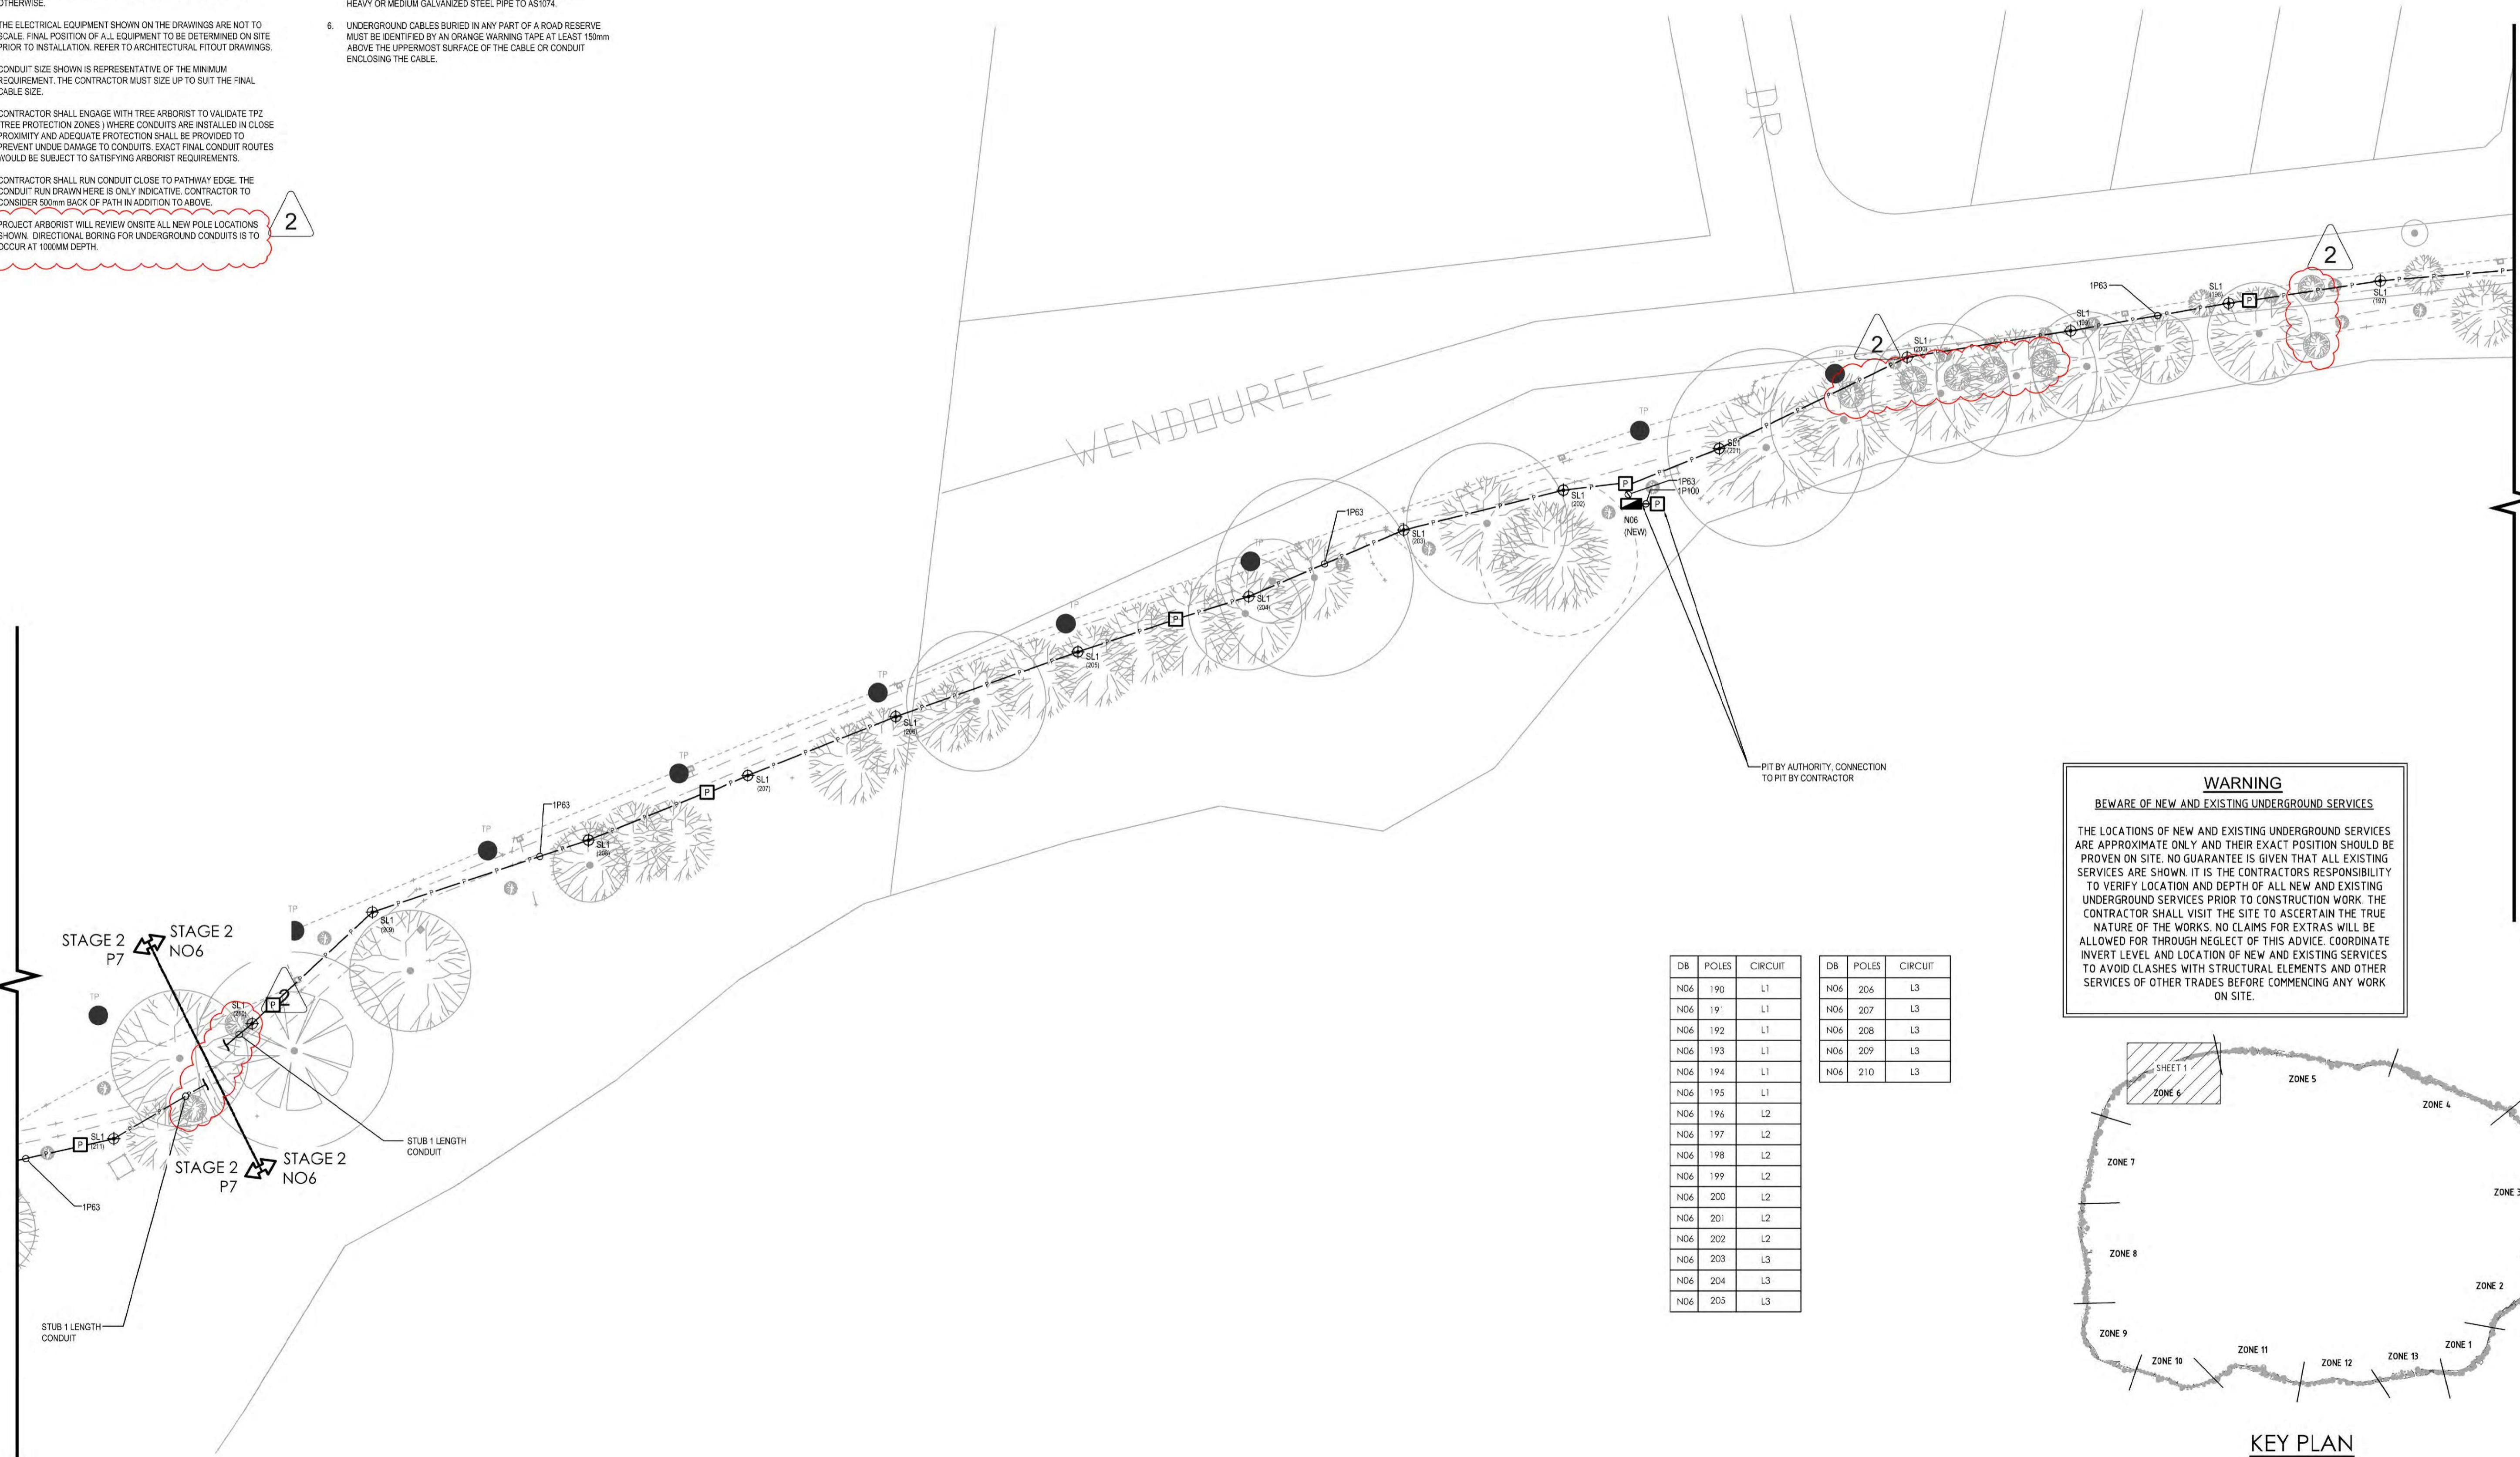


DB	POLES	CIRCUIT
ND6	190	L1
ND6	191	L1
ND6	192	L1
ND6	193	L1
ND6	194	L1
ND6	195	L1
ND6	196	L2
ND6	197	L2
ND6	198	L2
ND6	199	L2
ND6	200	L2
ND6	201	L2
ND6	202	L2
ND6	203	L3
ND6	204	L3
ND6	205	L3

DB	POLES	CIRCUIT
ND6	206	L3
ND6	207	L3
ND6	208	L3
ND6	209	L3
ND6	210	L3

WARNING
BEWARE OF NEW AND EXISTING UNDERGROUND SERVICES

THE LOCATIONS OF NEW AND EXISTING UNDERGROUND SERVICES ARE APPROXIMATE ONLY AND THEIR EXACT POSITION SHOULD BE PROVEN ON SITE. NO GUARANTEE IS GIVEN THAT ALL EXISTING SERVICES ARE SHOWN. IT IS THE CONTRACTORS RESPONSIBILITY TO VERIFY LOCATION AND DEPTH OF ALL NEW AND EXISTING UNDERGROUND SERVICES PRIOR TO CONSTRUCTION WORK. THE CONTRACTOR SHALL VISIT THE SITE TO ASCERTAIN THE TRUE NATURE OF THE WORKS. NO CLAIMS FOR EXTRAS WILL BE ALLOWED FOR THROUGH NEGLIGENCE OF THIS ADVICE. COORDINATE INVERT LEVEL AND LOCATION OF NEW AND EXISTING SERVICES TO AVOID CLASHES WITH STRUCTURAL ELEMENTS AND OTHER SERVICES OF OTHER TRADES BEFORE COMMENCING ANY WORK ON SITE.

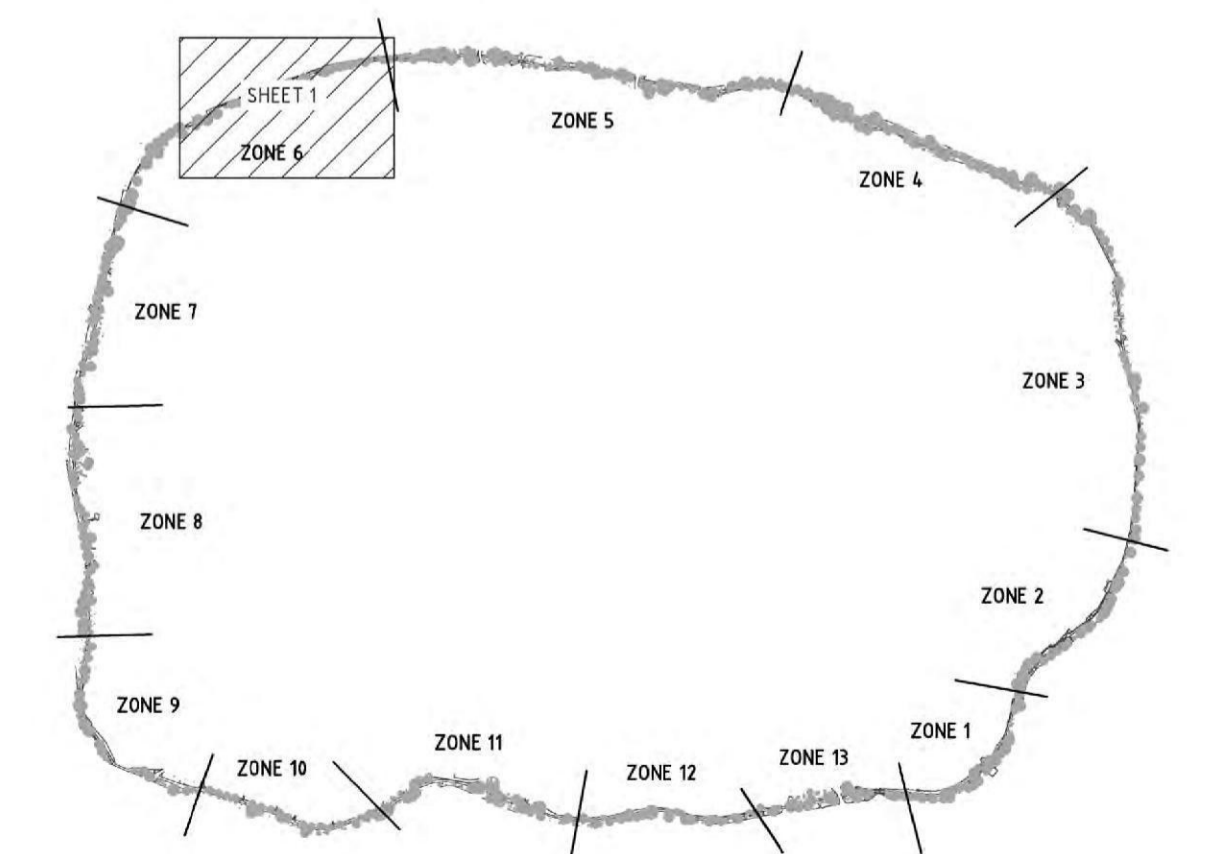

KEY PLAN

FOR CONTINUATION REFER TO DRAWING EL-2-09 (ZONE 5 - SHEET 2)

REV	DESCRIPTION	DRAWN	APPD	DATE
2	ISSUED FOR CONSTRUCTION	TRS	JPK	07.06.22
1	ISSUED FOR CONSTRUCTION	TRS	JPK	13.04.22

REPRODUCTION OF DRAWINGS
THE DRAWINGS HAVE BEEN DOCUMENTED IN COLOUR. AS SUCH, THE DRAWINGS ARE REQUIRED TO BE PRINTED IN COLOUR. FAILURE TO DO SO MAY RESULT IN LOSS OF INFORMATION. BLACK & WHITE PRINTING MAY BE USED IF SPECIFIC BLACK & WHITE DOCUMENTS HAVE BEEN OBTAINED FROM WGE.

ARCHITECT/CIENT

LAKE WENDOUREE, BALLARAT,
STEVE MONEGHETTI TRACK
PUBLIC LIGHTING

ZONE 6 - PROPOSED
LIGHTING & POWER LAYOUT -
STAGE 2 SHEET 1

PROJECT TITLE

45683-EL-2-'0.dwg

CONSTRUCTION ISSUE

Stantec

ELECTRICAL SERVICES

1:500 45683 EL-2-10 2

SCALE @ A1 PROJECT No DRAWING No REV

7/06/2022 4:54:57 PM


HERITAGE VICTORIA
HERITAGE VICTORIA
HERITAGE VICTORIA
HERITAGE VICTORIA

ENDORSED DOCUMENT
09/09/2022
VHR No. H2252 File No. -
Page 14 of 26
SIGNED *[Signature]*
Executive Director
NOTE: Conditions apply.

DB	POLES	CIRCUIT
P7	211	L1
P7	212	L1
P7	213	L1
P7	214	L1
P7	215	L1
P7	216	L1
P7	217	L1
P7	218	L1

DB	POLES	CIRCUIT
ND6	190	L1
ND6	191	L1
ND6	192	L1
ND6	193	L1
ND6	194	L1
ND6	195	L1
ND6	196	L2
ND6	197	L2
ND6	198	L2
ND6	199	L2
ND6	200	L2
ND6	201	L2
ND6	202	L2
ND6	203	L3
ND6	204	L3
ND6	205	L3

DB	POLES	CIRCUIT
ND6	206	L3
ND6	207	L3
ND6	208	L3
ND6	209	L3
ND6	210	L3

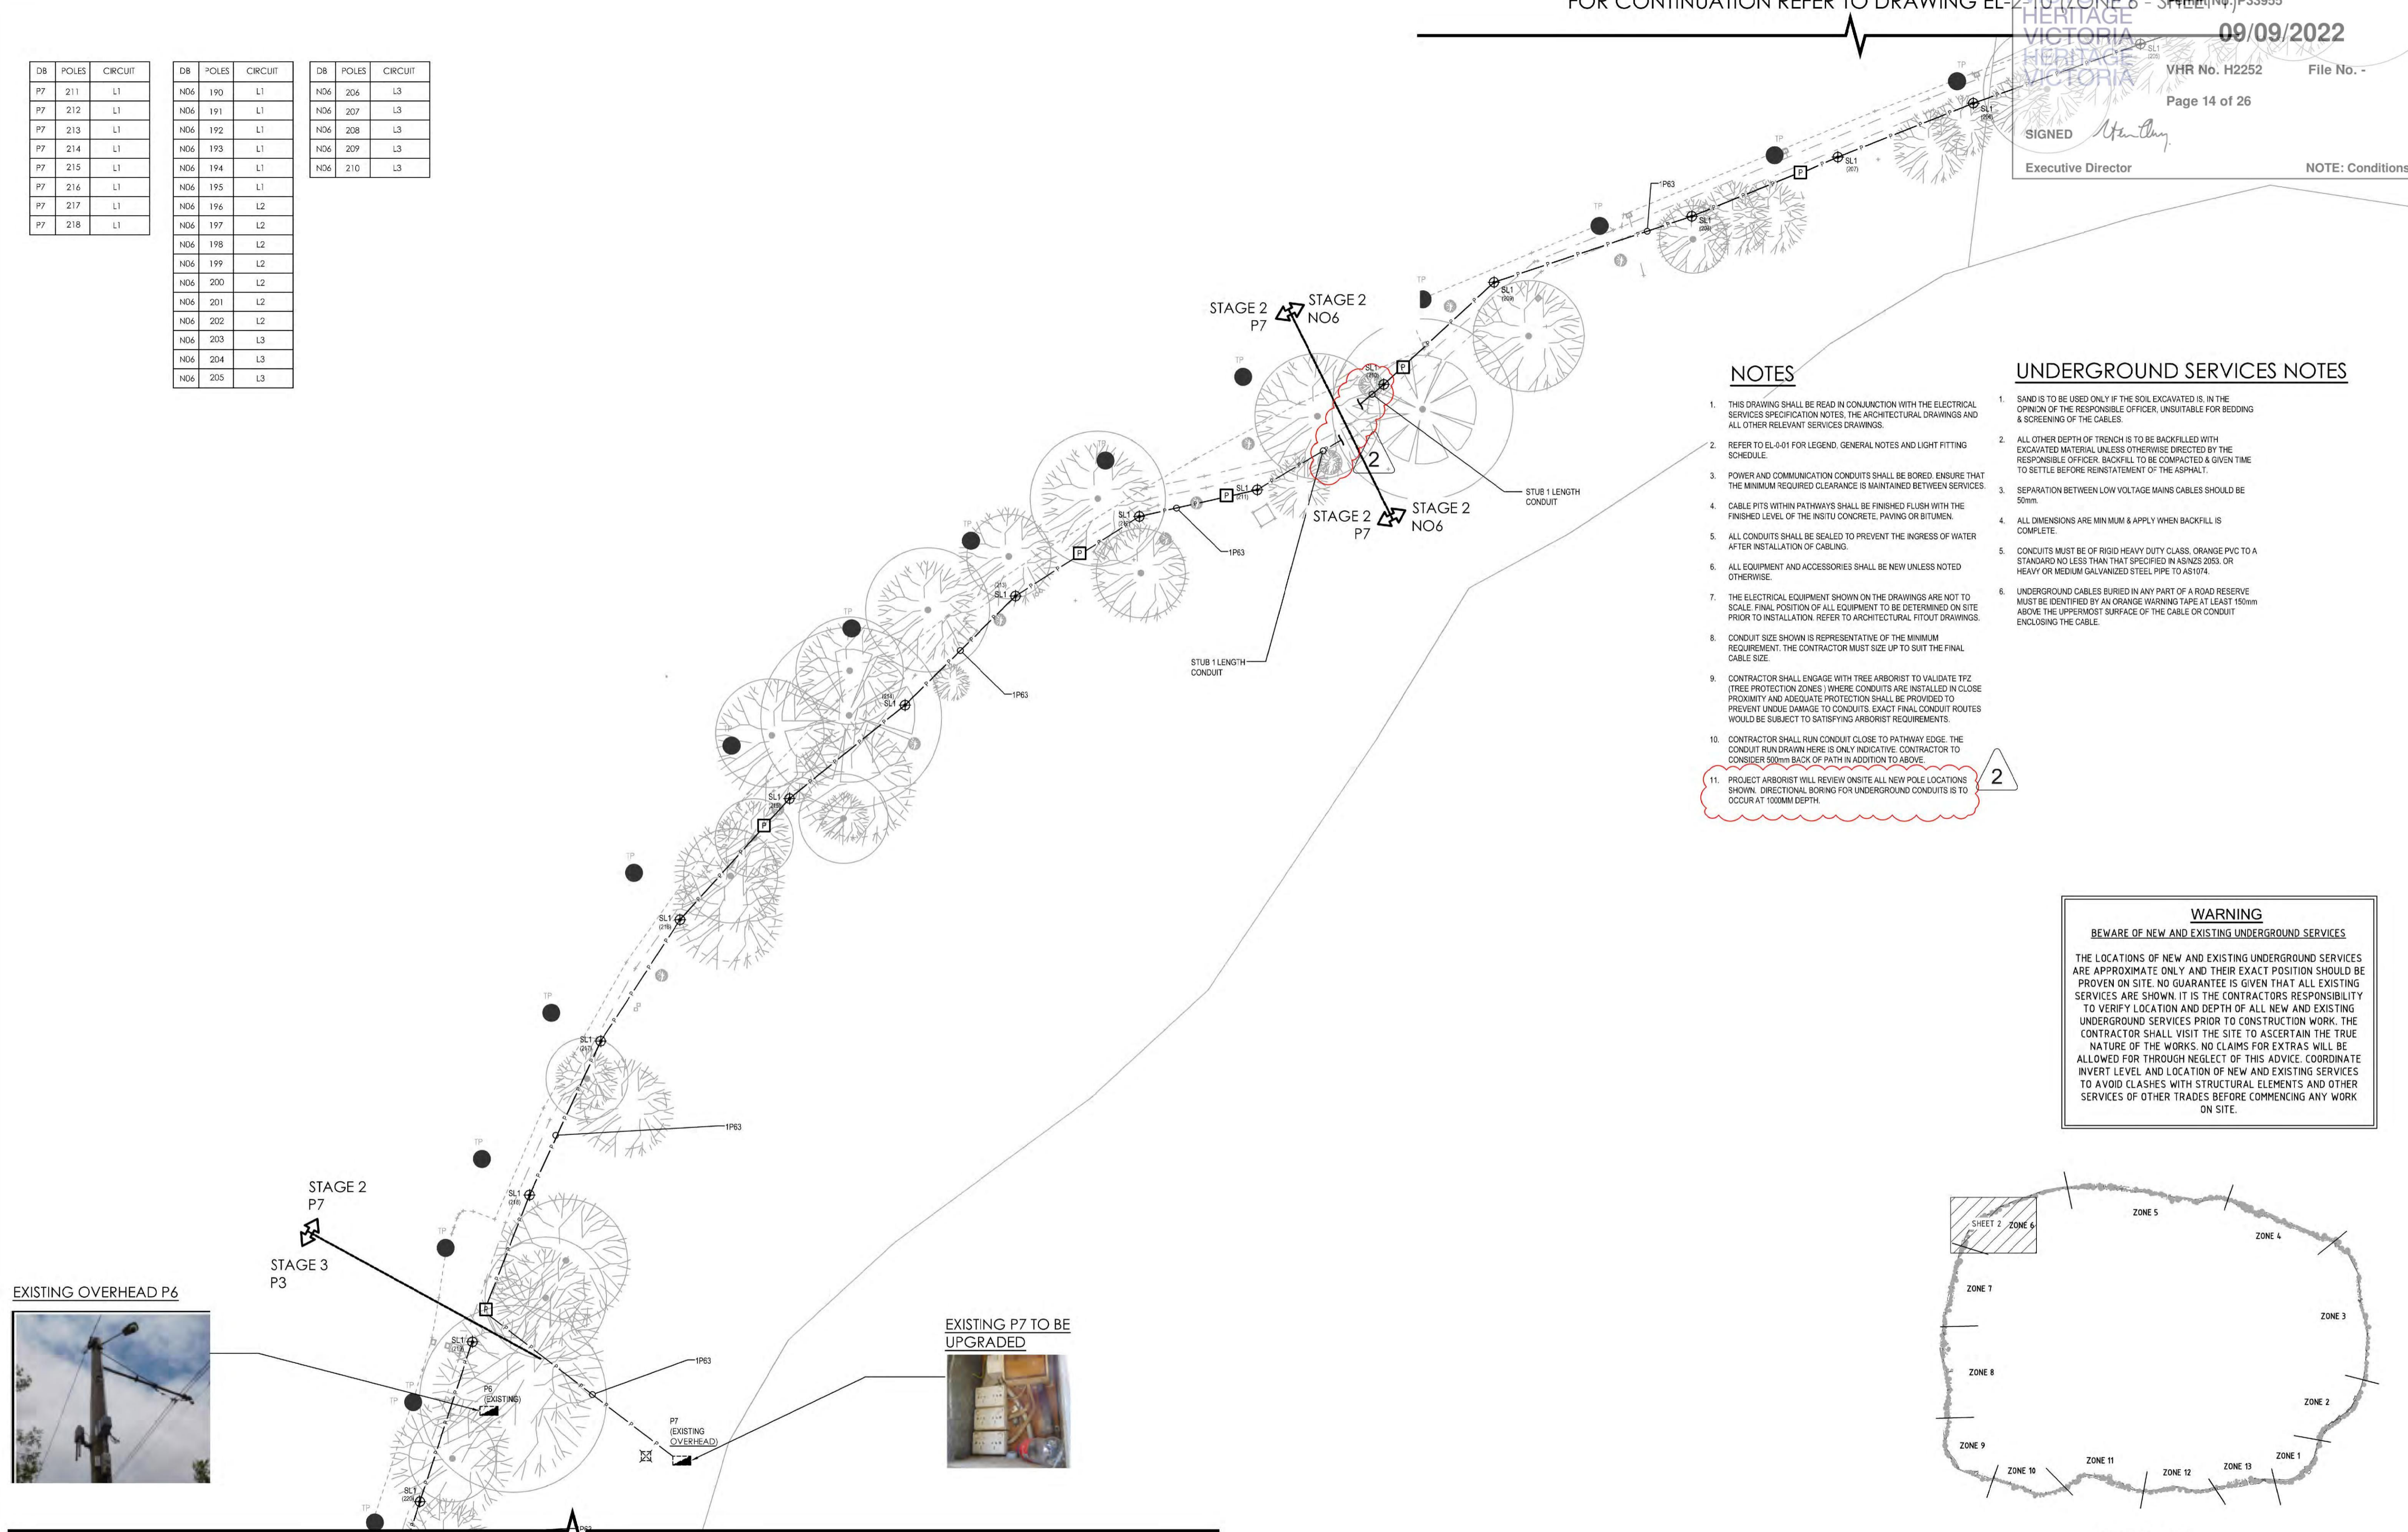

NOTES


- THIS DRAWING SHALL BE READ IN CONJUNCTION WITH THE ELECTRICAL SERVICES SPECIFICATION NOTES, THE ARCHITECTURAL DRAWINGS AND ALL OTHER RELEVANT SERVICES DRAWINGS.
- REFER TO EL-0-01 FOR LEGEND, GENERAL NOTES AND LIGHT FITTING SCHEDULE.
- POWER AND COMMUNICATION CONDUITS SHALL BE BORED. ENSURE THAT THE MINIMUM REQUIRED CLEARANCE IS MAINTAINED BETWEEN SERVICES.
- CABLE PITS WITHIN PATHWAYS SHALL BE FINISHED FLUSH WITH THE FINISHED LEVEL OF THE IN SITU CONCRETE, PAVING OR BITUMEN.
- ALL CONDUITS SHALL BE SEALED TO PREVENT THE INGRESS OF WATER AFTER INSTALLATION OF CABLING.
- ALL EQUIPMENT AND ACCESSORIES SHALL BE NEW UNLESS NOTED OTHERWISE.
- THE ELECTRICAL EQUIPMENT SHOWN ON THE DRAWINGS ARE NOT TO SCALE. FINAL POSITION OF ALL EQUIPMENT TO BE DETERMINED ON SITE PRIOR TO INSTALLATION. REFER TO ARCHITECTURAL FITOUT DRAWINGS.
- CONDUIT SIZE SHOWN IS REPRESENTATIVE OF THE MINIMUM REQUIREMENT. THE CONTRACTOR MUST SIZE UP TO SUIT THE FINAL CABLE SIZE.
- CONTRACTOR SHALL ENGAGE WITH TREE ARBORIST TO VALIDATE TPZ (TREE PROTECTION ZONES) WHERE CONDUITS ARE INSTALLED IN CLOSE PROXIMITY AND ADEQUATE PROTECTION SHALL BE PROVIDED TO PREVENT UNDUE DAMAGE TO CONDUITS. EXACT FINAL CONDUIT ROUTES WOULD BE SUBJECT TO SATISFYING ARBORIST REQUIREMENTS.
- CONTRACTOR SHALL RUN CONDUIT CLOSE TO PATHWAY EDGE. THE CONDUIT RUN DRAWN HERE IS ONLY INDICATIVE. CONTRACTOR TO CONSIDER 500mm BACK OF PATH IN ADDITION TO ABOVE.
- PROJECT ARBORIST WILL REVIEW ONSITE ALL NEW POLE LOCATIONS SHOWN. DIRECTIONAL BORING FOR UNDERGROUND CONDUITS IS TO OCCUR AT 1000MM DEPTH.

UNDERGROUND SERVICES NOTES

- SAND IS TO BE USED ONLY IF THE SOIL EXCAVATED IS, IN THE OPINION OF THE RESPONSIBLE OFFICER, UNSUITABLE FOR BEDDING & SCREENING OF THE CABLES.
- ALL OTHER DEPTH OF TRENCH IS TO BE BACKFILLED WITH EXCAVATED MATERIAL UNLESS OTHERWISE DIRECTED BY THE RESPONSIBLE OFFICER. BACKFILL TO BE COMPACTED & GIVEN TIME TO SETTLE BEFORE REINSTATEMENT OF THE ASPHALT.
- SEPARATION BETWEEN LOW VOLTAGE MAINS CABLES SHOULD BE 50mm.
- ALL DIMENSIONS ARE MINIMUM & APPLY WHEN BACKFILL IS COMPLETE.
- CONDUITS MUST BE OF RIGID HEAVY DUTY CLASS, ORANGE PVC TO A STANDARD NO LESS THAN THAT SPECIFIED IN AS/NZS 2053, OR HEAVY OR MEDIUM GALVANIZED STEEL PIPE TO AS1074.
- UNDERGROUND CABLES BURIED IN ANY PART OF A ROAD RESERVE MUST BE IDENTIFIED BY AN ORANGE WARNING TAPE AT LEAST 150mm ABOVE THE UPPERMOST SURFACE OF THE CABLE OR CONDUIT ENCLOSING THE CABLE.

WARNING
BEWARE OF NEW AND EXISTING UNDERGROUND SERVICES

THE LOCATIONS OF NEW AND EXISTING UNDERGROUND SERVICES ARE APPROXIMATE ONLY AND THEIR EXACT POSITION SHOULD BE PROVEN ON SITE. NO GUARANTEE IS GIVEN THAT ALL EXISTING SERVICES ARE SHOWN. IT IS THE CONTRACTORS RESPONSIBILITY TO VERIFY LOCATION AND DEPTH OF ALL NEW AND EXISTING UNDERGROUND SERVICES PRIOR TO CONSTRUCTION WORK. THE CONTRACTOR SHALL VISIT THE SITE TO ASCERTAIN THE TRUE NATURE OF THE WORKS. NO CLAIMS FOR EXTRAS WILL BE ALLOWED FOR THROUGH NEGLIGENCE OF THIS ADVICE. COORDINATE INVERT LEVEL AND LOCATION OF NEW AND EXISTING SERVICES TO AVOID CLASHES WITH STRUCTURAL ELEMENTS AND OTHER SERVICES OF OTHER TRADES BEFORE COMMENCING ANY WORK ON SITE.

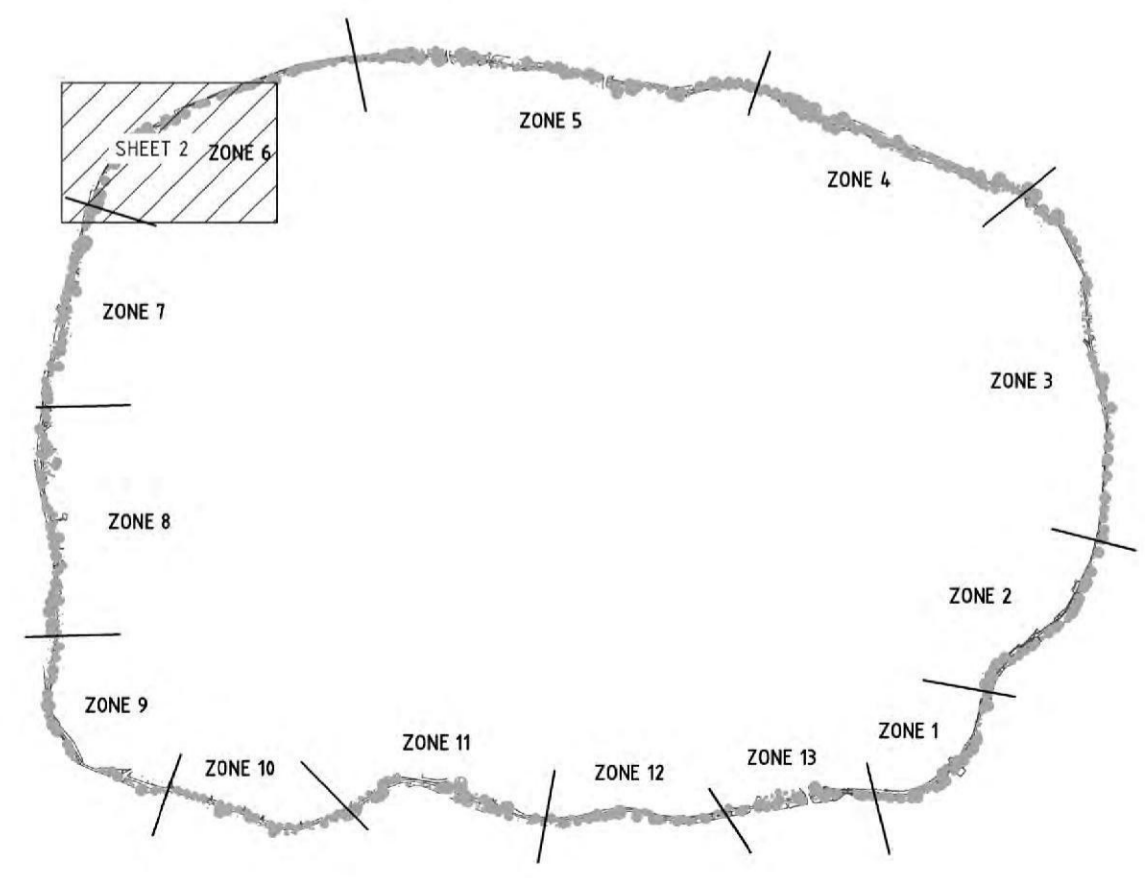

KEY PLAN

FOR CONTINUATION REFER TO DRAWING EL-2-12 (ZONE 7 - SHEET 1)

REV	DESCRIPTION	DRAWN	APPD	DATE
2	ISSUED FOR CONSTRUCTION	TRS	JPK	07.06.22
1	ISSUED FOR CONSTRUCTION	TRS	JPK	13.04.22

REPRODUCTION OF DRAWINGS
THE DRAWINGS HAVE BEEN DOCUMENTED IN COLOUR. AS SUCH, THE DRAWINGS ARE REQUIRED TO BE PRINTED IN COLOUR. FAILURE TO DO SO MAY RESULT IN LOSS OF INFORMATION. BLACK & WHITE PRINTING MAY BE USED IF SPECIFIC BLACK & WHITE DOCUMENTS HAVE BEEN OBTAINED FROM WGE.

CITY OF BALLARAT

ARCHITECT/CIENT

LAKE WENDOUREE, BALLARAT, STEVE MONEGHETTI TRACK
PUBLIC LIGHTING

ZONE 6 - PROPOSED LIGHTING & POWER LAYOUT - STAGE 2 SHEET 2

PROJECT TITLE

CONSTRUCTION ISSUE

ELECTRICAL SERVICES

1:500 45683 EL-2-11 2

SCALE @ A1 PROJECT No DRAWING No REV

HERITAGE VICTORIA HERITAGE VICTORIA HERITAGE VICTORIA

Permit No. P33955

NOTES: 09/09/2022

THIS DRAWING SHALL BE READ IN CONJUNCTION WITH THE ELECTRICAL SERVICES SPECIFICATION NOTES, THE ARCHITECTURAL DRAWINGS AND ALL OTHER RELEVANT INFORMATION.

2. REFER TO EL-2-01 FOR LEGEND, GENERAL NOTES AND LIGHT FITTING SCHEDULE.

Page 15 of 26


SIGNED: [Signature]

Executive Director: [Signature]

NOTE: Conditions apply.

(NOTE 11)

DB	POLES	CIRCUIT
P3	1	L1
P3	2	L1
P3	3	L1
P3	4	L1
P3	5	L1
P3	6	L1
P3	7	L1
P3	8	L1
P3	9	L1
P3	219	L2
P3	220	L2
P3	221	L2
P3	222	L2
P3	223	L2
P3	224	L2

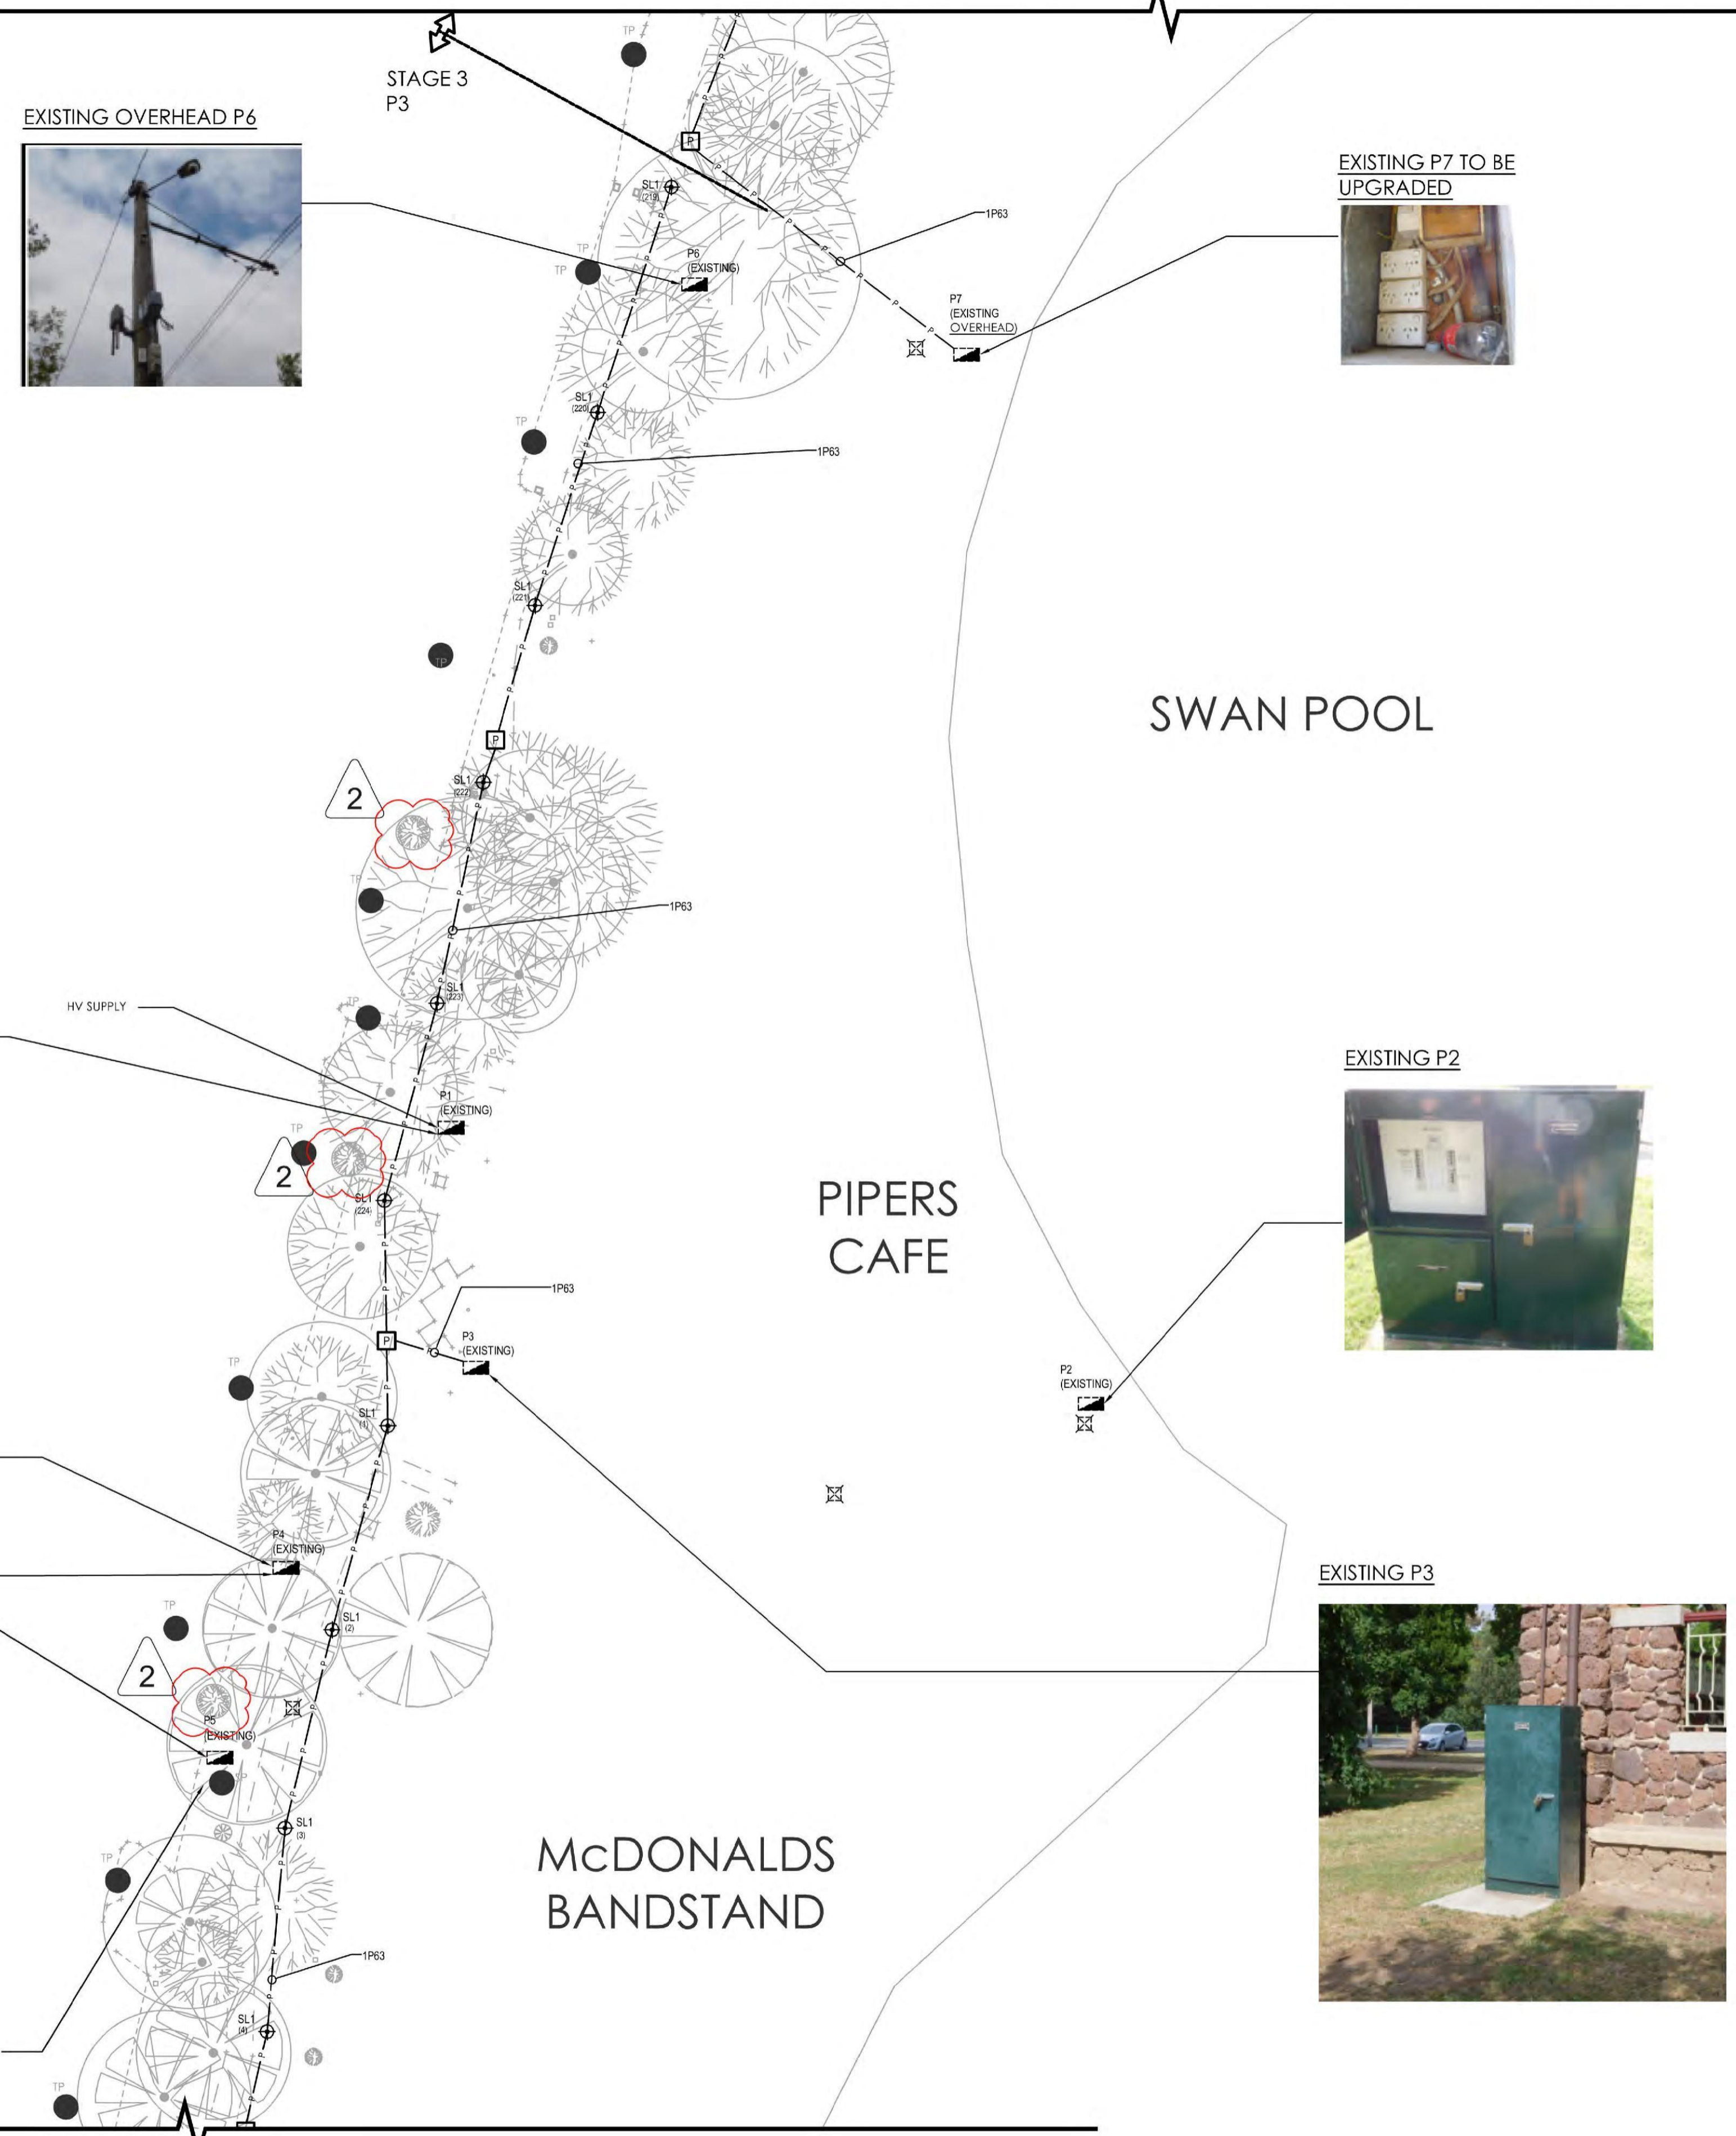


3. POWER AND COMMUNICATION CONDUITS SHALL BE BORED. ENSURE THAT MINIMUM CLEARANCE IS MAINTAINED BETWEEN SERVICES.
4. CABLE PITS WITHIN PATHWAYS SHALL BE FINISHED FLUSH WITH THE LEVEL OF THE IN-SITU CONCRETE, PAVING OR BITUMEN.
5. ALL CONDUITS SHALL BE SEALED TO PREVENT THE INGRESS OF WATER AFTER INSTALLATION OF CABLING.
6. ALL EQUIPMENT AND ACCESSORIES SHALL BE NEW UNLESS NOTED OTHERWISE.
7. THE ELECTRICAL EQUIPMENT SHOWN ON THE DRAWINGS ARE NOT TO SCALE. FINAL POSITION OF ALL EQUIPMENT TO BE DETERMINED ON SITE PRIOR TO INSTALLATION. REFER TO ARCHITECTURAL FITOUT DRAWINGS.
8. CONDUIT SIZE SHOWN IS REPRESENTATIVE OF THE MINIMUM REQUIREMENT. THE CONTRACTOR MUST SIZE UP TO SUIT THE FINAL CABLE SIZE.
9. CONTRACTOR SHALL ENGAGE WITH TREE ARBORIST TO VALIDATE TPZ (TREE PROTECTION ZONES) WHERE CONDUITS ARE INSTALLED IN CLOSE PROXIMITY AND ADEQUATE PROTECTION SHALL BE PROVIDED TO PREVENT UNDUE DAMAGE TO CONDUITS. EXACT FINAL CONDUIT ROUTES WOULD BE SUBJECT TO SATISFYING ARBORIST REQUIREMENTS.
10. CONTRACTOR SHALL RUN CONDUIT CLOSE TO PATHWAY EDGE. THE CONDUIT RUN DRAWN HERE IS ONLY INDICATIVE. CONTRACTOR TO CONSIDER 500mm BACK OF PATH IN ADDITION TO ABOVE.
11. CONTRACTOR TO ATTEND SITE AND IDENTIFY THE SPARE POLE NUMBERS FOR THIS BOARD. CIRCUITING SCHEDULE TO BE UPDATED AS PART OF THE AS BUILT DOCUMENTATION.
12. PROJECT ARBORIST WILL REVIEW ONSITE ALL NEW POLE LOCATIONS SHOWN. DIRECT ONAL BORING FOR UNDERGROUND CONDUITS IS TO OCCUR AT 1000MM DEPTH.

- UNDERGROUND SERVICES NOTES**
- SAND IS TO BE USED ONLY IF THE SOIL EXCAVATED IS, IN THE OPINION OF THE RESPONSIBLE OFFICER, UNSUITABLE FOR BEDDING & SCREENING OF THE CABLES.
 - ALL OTHER DEPTH OF TRENCH IS TO BE BACK-FILLED WITH EXCAVATED MATERIAL UNLESS OTHERWISE DIRECTED BY THE RESPONSIBLE OFFICER. BACKFILL TO BE COMPACTED & GIVEN TIME TO SETTLE BEFORE REINSTATEMENT OF THE ASPHALT.
 - SEPARATION BETWEEN LOW VOLTAGE MAINS CABLES SHOULD BE 50mm.
 - ALL DIMENSIONS ARE MINIMUM & APPLY WHEN BACKFILL IS COMPLETE.
 - CONDUITS MUST BE OF RIGID HEAVY DUTY CLASS, ORANGE PVC TO A STANDARD NO LESS THAN THAT SPECIFIED IN AS/NZS 2053, OR HEAVY OR MEDIUM GALVANIZED STEEL PIPE TO AS1074.
 - UNDERGROUND CABLES BURIED IN ANY PART OF A ROAD RESERVE MUST BE IDENTIFIED BY AN ORANGE WARNING TAPE AT LEAST 150mm ABOVE THE UPPERMOST SURFACE OF THE CABLE OR CONDUIT ENCLOSED THE CABLE.

WARNING
BEWARE OF NEW AND EXISTING UNDERGROUND SERVICES

THE LOCATIONS OF NEW AND EXISTING UNDERGROUND SERVICES ARE APPROXIMATE ONLY AND THEIR EXACT POSITION SHOULD BE PROVEN ON SITE. NO GUARANTEE IS GIVEN THAT ALL EXISTING SERVICES ARE SHOWN. IT IS THE CONTRACTORS RESPONSIBILITY TO VERIFY LOCATION AND DEPTH OF ALL NEW AND EXISTING UNDERGROUND SERVICES PRIOR TO CONSTRUCTION WORK. THE CONTRACTOR SHALL VISIT THE SITE TO ASCERTAIN THE TRUE NATURE OF THE WORKS. NO CLAIMS FOR EXTRAS WILL BE ALLOWED FOR THROUGH NEGLIGENCE OF THIS ADVICE. COORDINATE INVERT LEVEL AND LOCATION OF NEW AND EXISTING SERVICES TO AVOID CLASHES WITH STRUCTURAL ELEMENTS AND OTHER SERVICES OF OTHER TRADES BEFORE COMMENCING ANY WORK ON SITE.

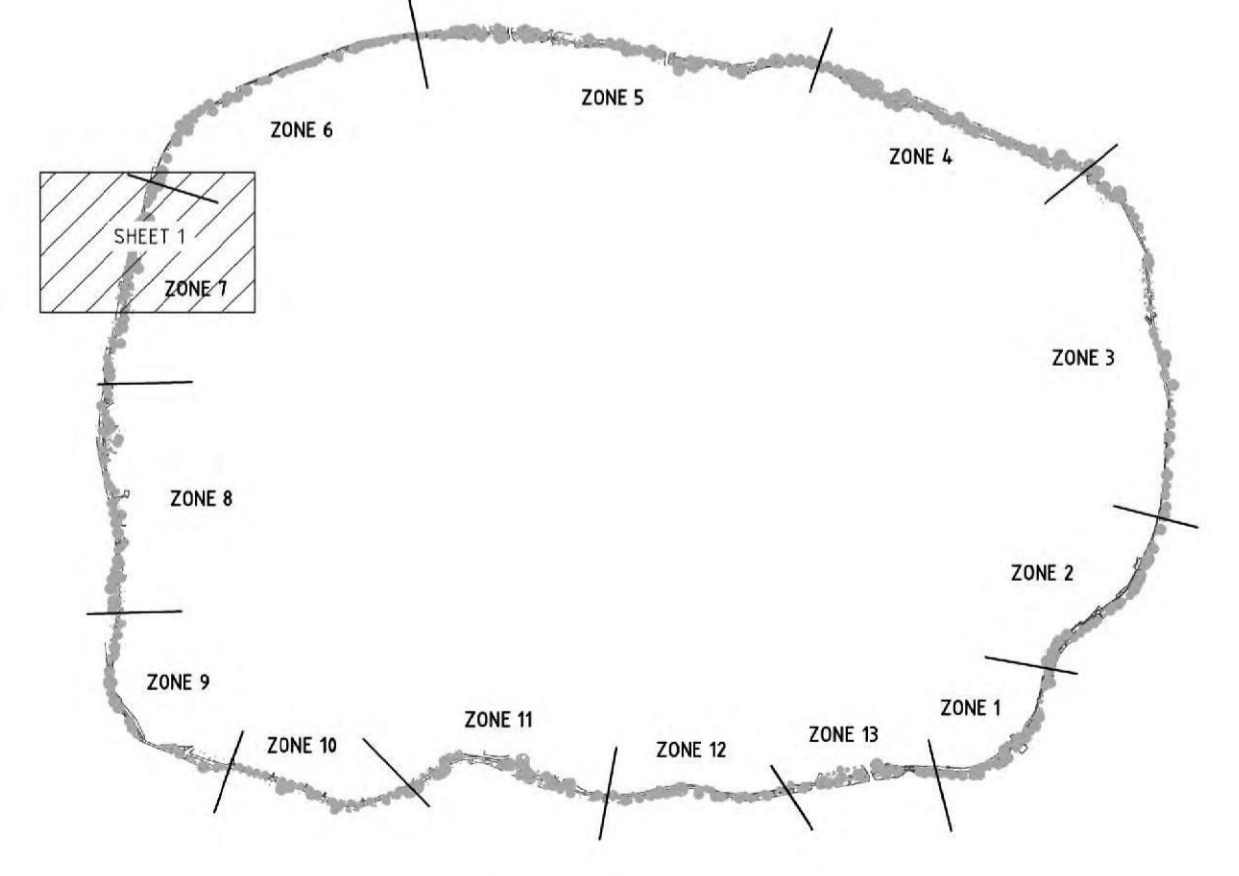

REPRODUCTION OF DRAWINGS

THE DRAWINGS HAVE BEEN DOCUMENTED IN COLOUR. AS SUCH, THE DRAWINGS ARE REQUIRED TO BE PRINTED IN COLOUR. FAILURE TO DO SO MAY RESULT IN LOSS OF INFORMATION. BLACK & WHITE PRINTING MAY BE USED IF SPECIFIC BLACK & WHITE DOCUMENTS HAVE BEEN OBTAINED FROM WGE.

CITY OF BALLARAT

ARCHITECT/CIENT

LAKE WENDOUREE, BALLARAT, STEVE MONEGHETTI TRACK PUBLIC LIGHTING

ZONE 7 - PROPOSED LIGHTING & POWER LAYOUT - STAGE 3 SHEET 1

PROJECT: 45683-EL-2-2.dwg

TITLE: 45683-EL-2-2.dwg

CONSTRUCTION ISSUE

Stantec

ELECTRICAL SERVICES

1:500 45683 EL-2-12 2

SCALE @ A1 PROJECT No DRAWING No REV



REV	DESCRIPTION	DRAWN	APPD	DATE
2	ISSUED FOR CONSTRUCTION	TRS	JPK	07.06.22
1	ISSUED FOR CONSTRUCTION	TRS	JPK	13.04.22

FOR CONTINUATION REFER TO DRAWING EL-2-12 (ZONE 7 - SHEET 1)


(NOTE 11)

DB	POLES	CIRCUIT
P3	1	L1
P3	2	L1
P3	3	L1
P3	4	L1
P3	5	L1
P3	6	L1
P3	7	L1
P3	8	L1
P3	9	L1
P3	219	L2
P3	220	L2
P3	221	L2
P3	222	L2
P3	223	L2
P3	224	L2
P3	211	L3
P3	212	L3
P3	213	L3
P3	214	L3
P3	215	L3
P3	216	L3
P3	217	L3
P3	218	L3

EXISTING P4



EXISTING P5

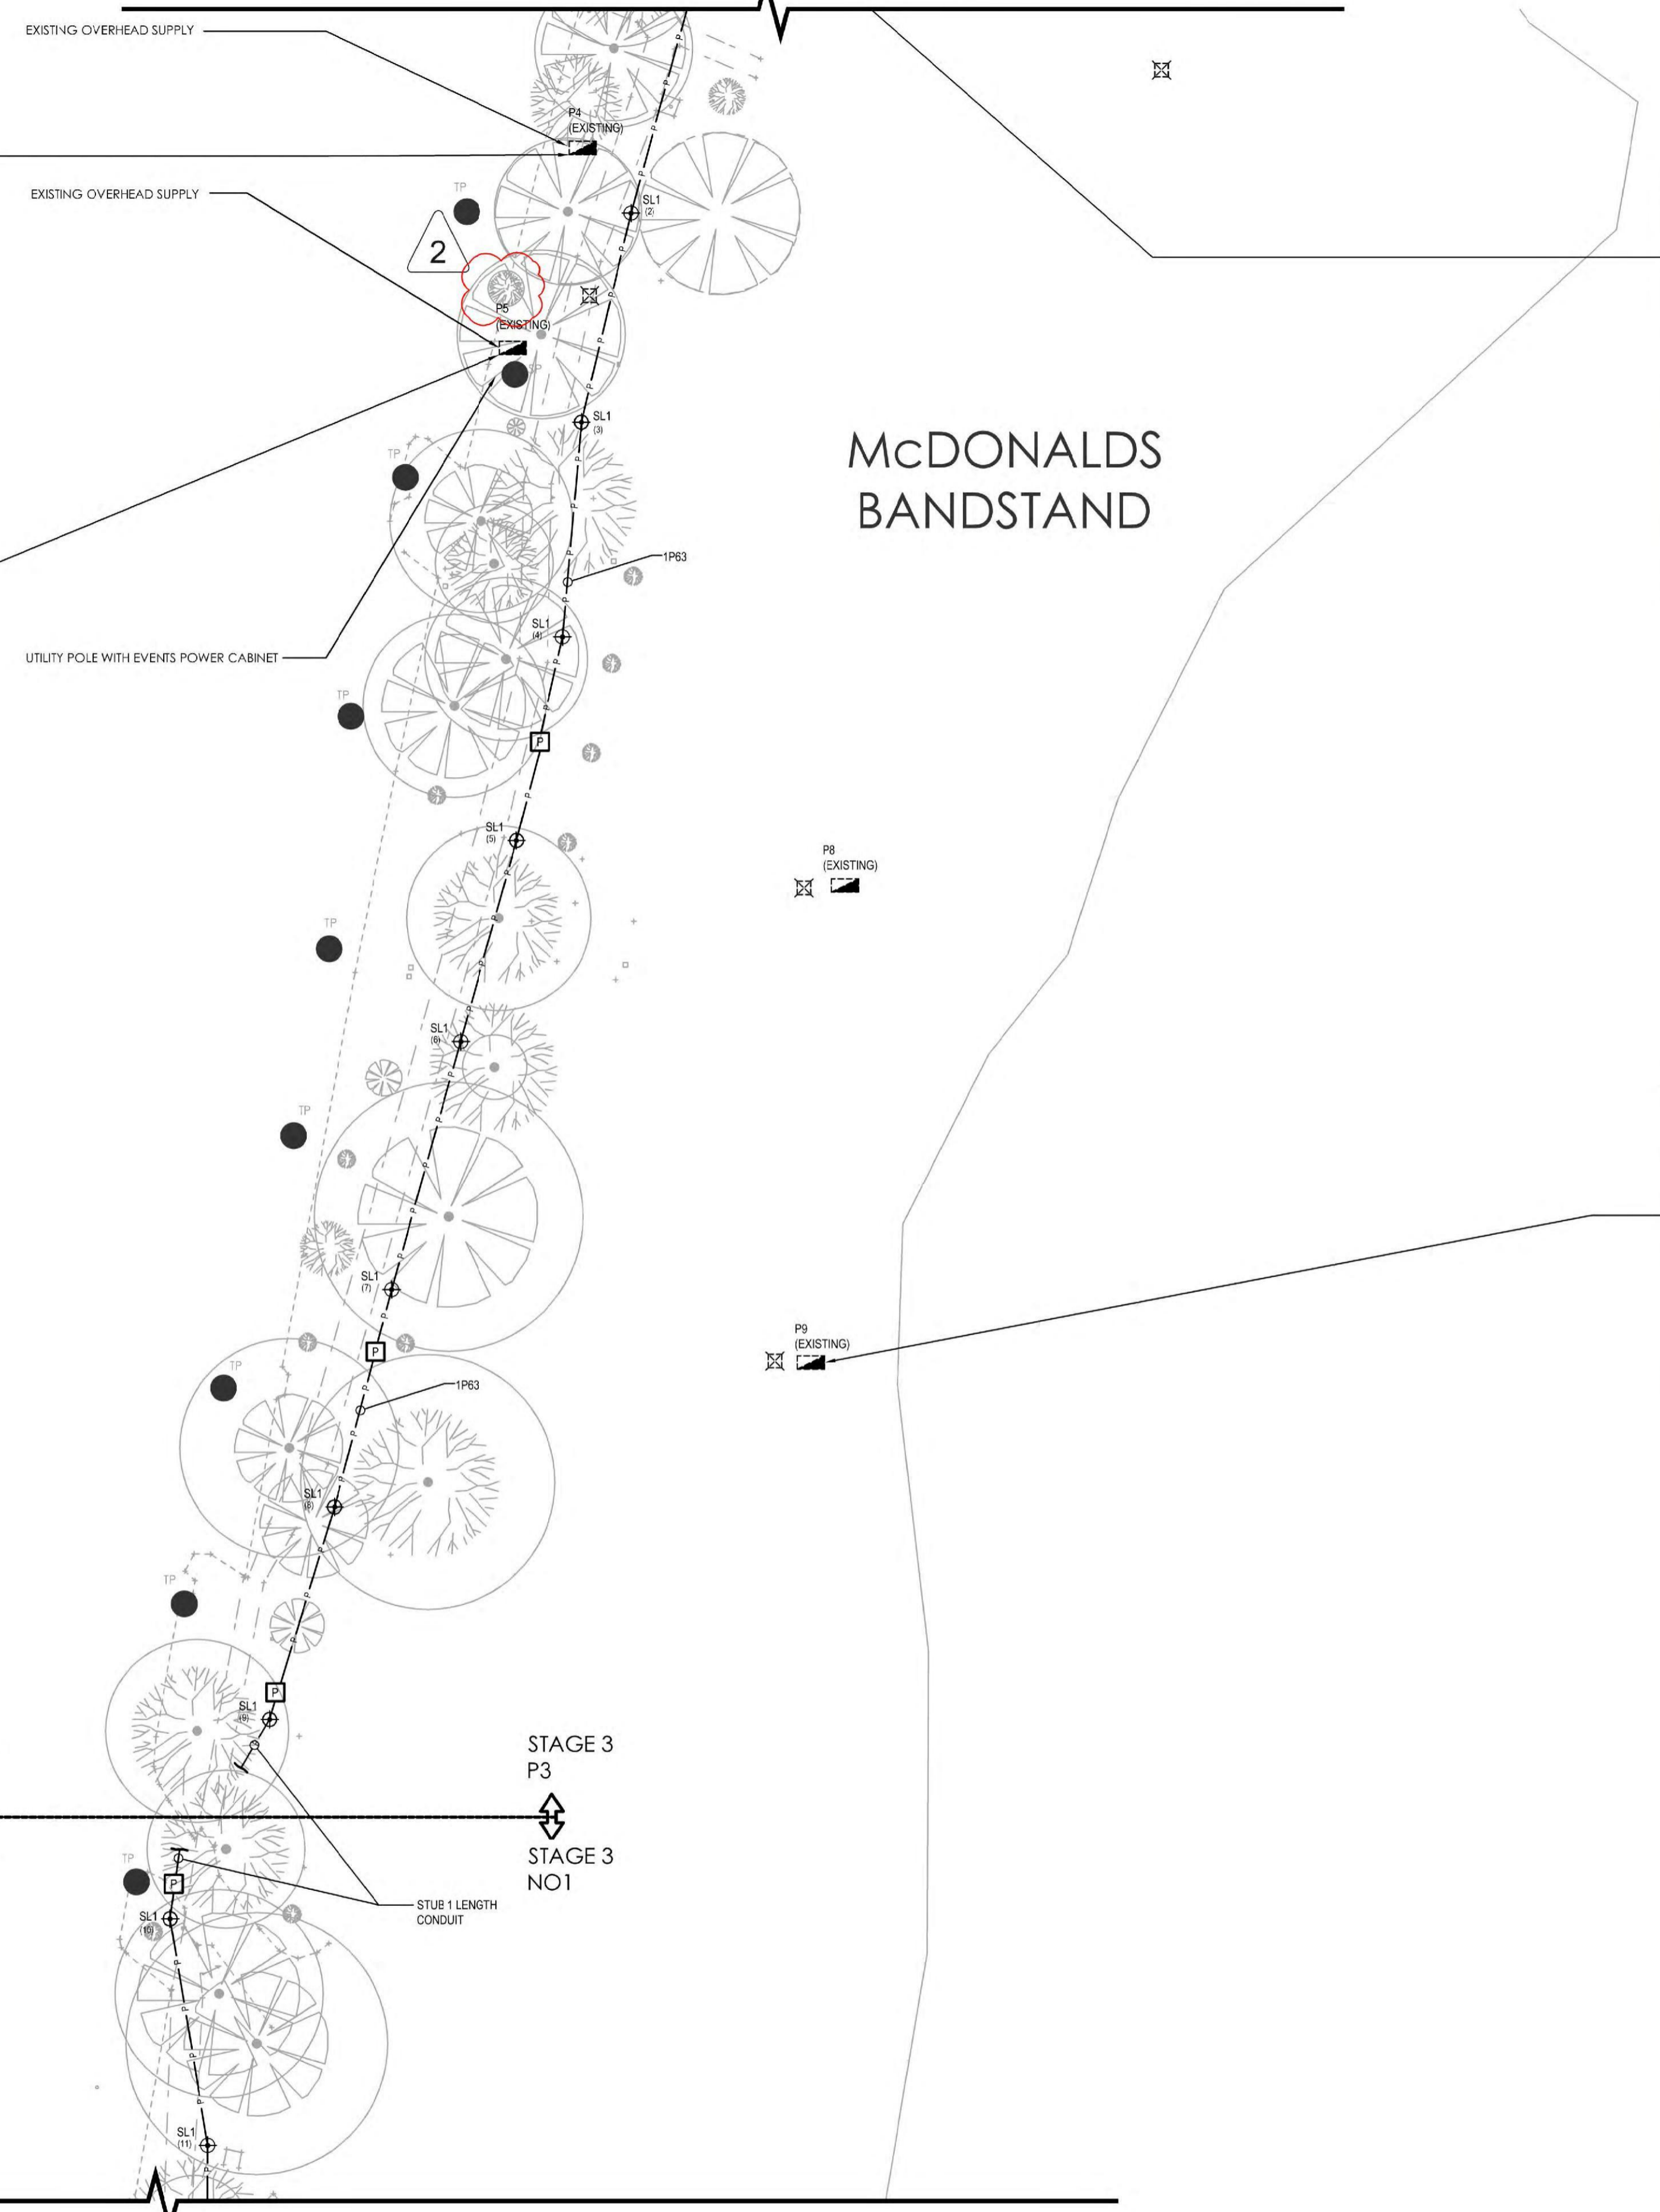

EXISTING P3



EXISTING P9



SIGNED: [Signature]
 Executive Director



- NOTE: Conditions apply.
1. ALL FITS WITHIN PATHWAYS SHALL BE FINISHED FLUSH WITH THE FINISHED LEVEL OF THE IN-SITU CONCRETE, PAVING OR BITUMEN.
 2. REFER TO EL-2-01 FOR LEGEND, GENERAL NOTES AND LIGHT FITTING SCHEDULE.
 3. POWER AND COMMUNICATION CONDUITS SHALL BE BORED. ENSURE THAT THE MINIMUM REQUIRED CLEARANCE IS MAINTAINED BETWEEN SERVICES.
 4. ALL CONDUITS SHALL BE SEALED TO PREVENT THE INGRESS OF WATER AFTER INSTALLATION OF CABLING.
 5. ALL EQUIPMENT AND ACCESSORIES SHALL BE NEW UNLESS NOTED OTHERWISE.
 6. THE ELECTRICAL EQUIPMENT SHOWN ON THE DRAWINGS ARE NOT TO SCALE. FINAL POSITION OF ALL EQUIPMENT TO BE DETERMINED ON SITE PRIOR TO INSTALLATION. REFER TO ARCHITECTURAL FITOUT DRAWINGS.
 7. CONDUIT SIZE SHOWN IS REPRESENTATIVE OF THE MINIMUM REQUIREMENT. THE CONTRACTOR MUST SIZE UP TO SUIT THE FINAL CABLE SIZE.
 8. CONTRACTOR SHALL ENGAGE WITH TREE ARBORIST TO VALIDATE TPZ (TREE PROTECTION ZONES) WHERE CONDUITS ARE INSTALLED IN CLOSE PROXIMITY AND ADEQUATE PROTECTION SHALL BE PROVIDED TO PREVENT UNDESTRUCTIVE DAMAGE TO CONDUITS. EXACT FINAL CONDUIT ROUTES WOULD BE SUBJECT TO SATISFYING ARBORIST REQUIREMENTS.
 9. CONTRACTOR SHALL RUN CONDUIT CLOSE TO PATHWAY EDGE. THE CONDUIT RUN DRAWN HERE IS ONLY INDICATIVE. CONTRACTOR TO CONSIDER 50mm BACK OF PATH IN ADDITION TO ABOVE.
 10. CONTRACTOR TO ATTEND SITE AND IDENTIFY THE SPARE POLE NUMBERS FOR THIS BOARD. CIRCUITING SCHEDULE TO BE UPDATED AS PART OF THE AS-BUILT DOCUMENTATION.
 11. PROJECT ARBORIST WILL REVIEW ONSITE ALL NEW POLE LOCATIONS SHOWN. DIRECTIONAL BORING FOR UNDERGROUND CONDUITS IS TO OCCUR AT 100MM DEPTH.

UNDERGROUND SERVICES NOTES

1. SAND IS TO BE USED ONLY IF THE SOIL EXCAVATED IS, IN THE OPINION OF THE RESPONSIBLE OFFICER, UNSUITABLE FOR BEDDING & SCREENING OF THE CABLES.
2. ALL OTHER DEPTH OF TRENCH IS TO BE BACKFILLED WITH EXCAVATED MATERIAL UNLESS OTHERWISE DIRECTED BY THE RESPONSIBLE OFFICER. BACKFILL TO BE COMPACTED & GIVEN TIME TO SETTLE BEFORE REINSTATEMENT OF THE ASPHALT.
3. SEPARATION BETWEEN LOW VOLTAGE MAINS CABLES SHOULD BE 50mm.
4. ALL DIMENSIONS ARE MINIMUM & APPLY WHEN BACKFILL IS COMPLETE.
5. CONDUITS MUST BE OF RIGID HEAVY DUTY CLASS, ORANGE PVC TO A STANDARD NO LESS THAN THAT SPECIFIED IN AS/NZS 2053, OR HEAVY OR MEDIUM GALVANIZED STEEL PIPE TO AS1074.
6. UNDERGROUND CABLES BURIED IN ANY PART OF A ROAD RESERVE MUST BE IDENTIFIED BY AN ORANGE WARNING TAPE AT LEAST 150mm ABOVE THE UPPERMOST SURFACE OF THE CABLE OR CONDUIT ENCLOSED THE CABLE.

WARNING
 BEWARE OF NEW AND EXISTING UNDERGROUND SERVICES

THE LOCATIONS OF NEW AND EXISTING UNDERGROUND SERVICES ARE APPROXIMATE ONLY AND THEIR EXACT POSITION SHOULD BE PROVEN ON SITE. NO GUARANTEE IS GIVEN THAT ALL EXISTING SERVICES ARE SHOWN. IT IS THE CONTRACTORS RESPONSIBILITY TO VERIFY LOCATION AND DEPTH OF ALL NEW AND EXISTING UNDERGROUND SERVICES PRIOR TO CONSTRUCTION WORK. THE CONTRACTOR SHALL VISIT THE SITE TO ASCERTAIN THE TRUE NATURE OF THE WORKS. NO CLAIMS FOR EXTRAS WILL BE ALLOWED FOR THROUGH NEGLIGENCE OF THIS ADVICE. COORDINATE INVERT LEVEL AND LOCATION OF NEW AND EXISTING SERVICES TO AVOID CLASHES WITH STRUCTURAL ELEMENTS AND OTHER SERVICES OF OTHER TRADES BEFORE COMMENCING ANY WORK ON SITE.

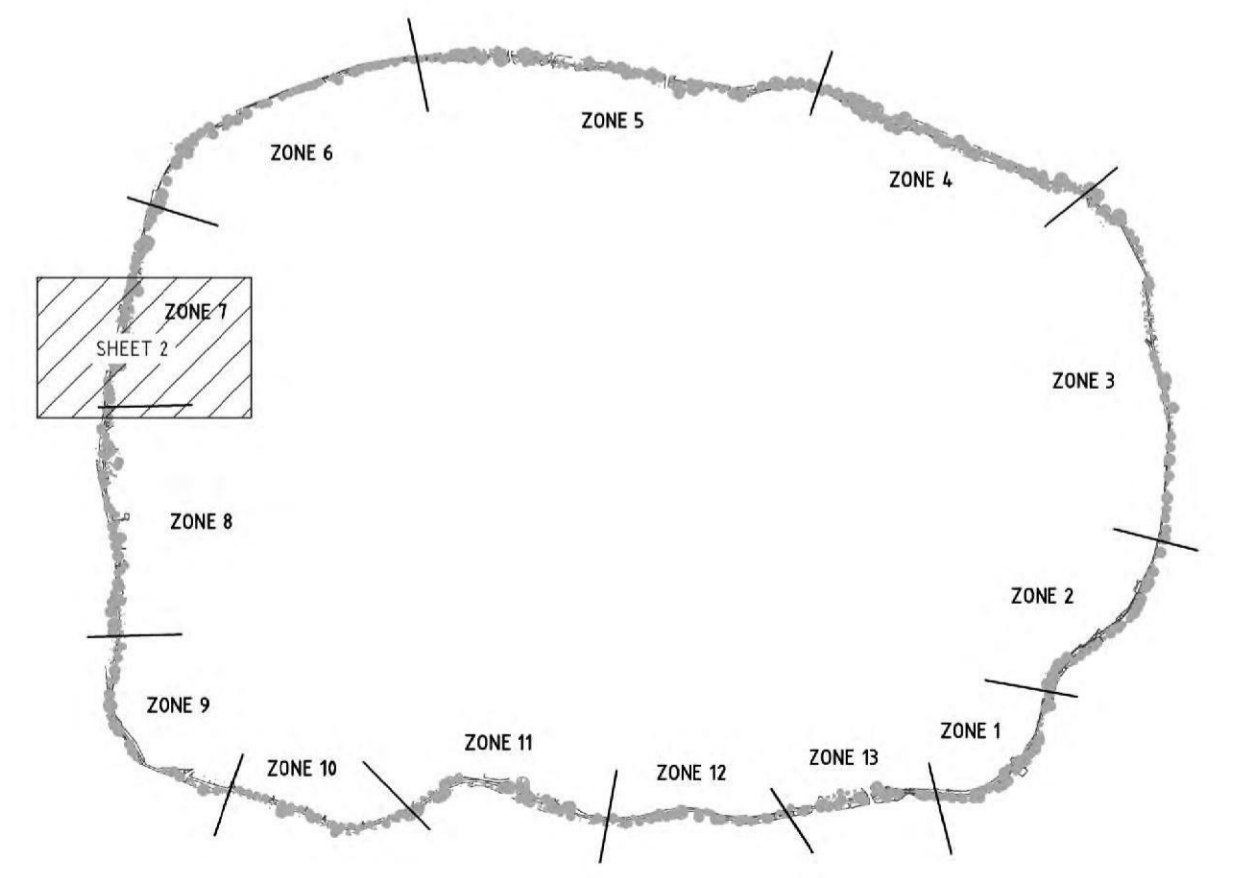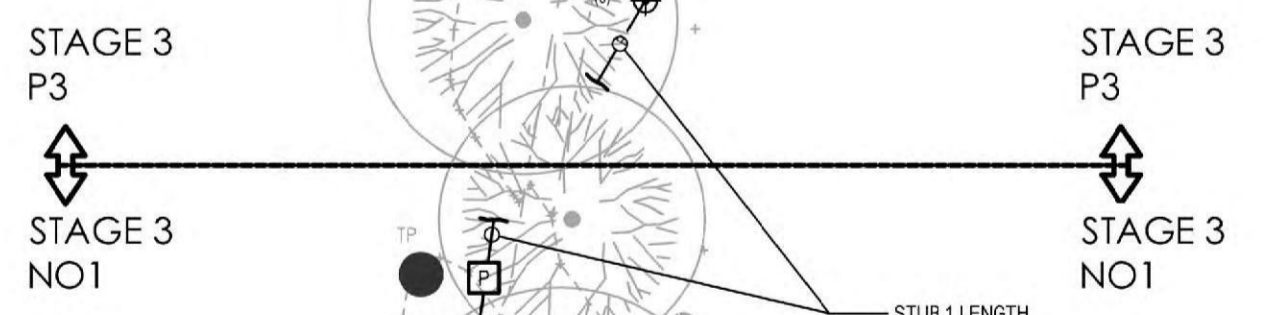

KEY PLAN

FOR CONTINUATION REFER TO DRAWING EL-2-14 (ZONE 8 - SHEET 1)

REV	DESCRIPTION	DRAWN	APPD	DATE
2	ISSUED FOR CONSTRUCTION	TRS	JPK	07.06.22
1	ISSUED FOR CONSTRUCTION	TRS	JPK	13.04.22

REPRODUCTION OF DRAWINGS
 THE DRAWINGS HAVE BEEN DOCUMENTED IN COLOUR. AS SUCH, THE DRAWINGS ARE REQUIRED TO BE PRINTED IN COLOUR. FAILURE TO DO SO MAY RESULT IN LOSS OF INFORMATION. BLACK & WHITE PRINTING MAY BE USED IF SPECIFIC BLACK & WHITE DOCUMENTS HAVE BEEN OBTAINED FROM WGE.

ARCHITECT/CIENT

LAKE WENDOUREE, BALLARAT, STEVE MONEGHETTI TRACK
 PUBLIC LIGHTING

ZONE 7 - PROPOSED LIGHTING & POWER LAYOUT - STAGE 3 SHEET 2

PROJECT TITLE

45683-EL-2-'3.dwg

CONSTRUCTION ISSUE

Stantec

ELECTRICAL SERVICES


1:500 45683 EL-2-13 2

SCALE @ A1 PROJECT No DRAWING No REV

7/06/2022 4:59:26 PM

FOR CONTINUATION REFER TO DRAWING EL-2-13 (ZONE 7 - SHEET 2)

DB	POLES	CIRCUIT
N01	10	L1
N01	11	L1
N01	12	L1
N01	13	L1
N01	14	L1
N01	15	L1
N01	16	L1
N01	17	L1
N01	18	L2
N01	19	L2
N01	20	L2
N01	21	L2
N01	22	L2
N01	22-1	L2

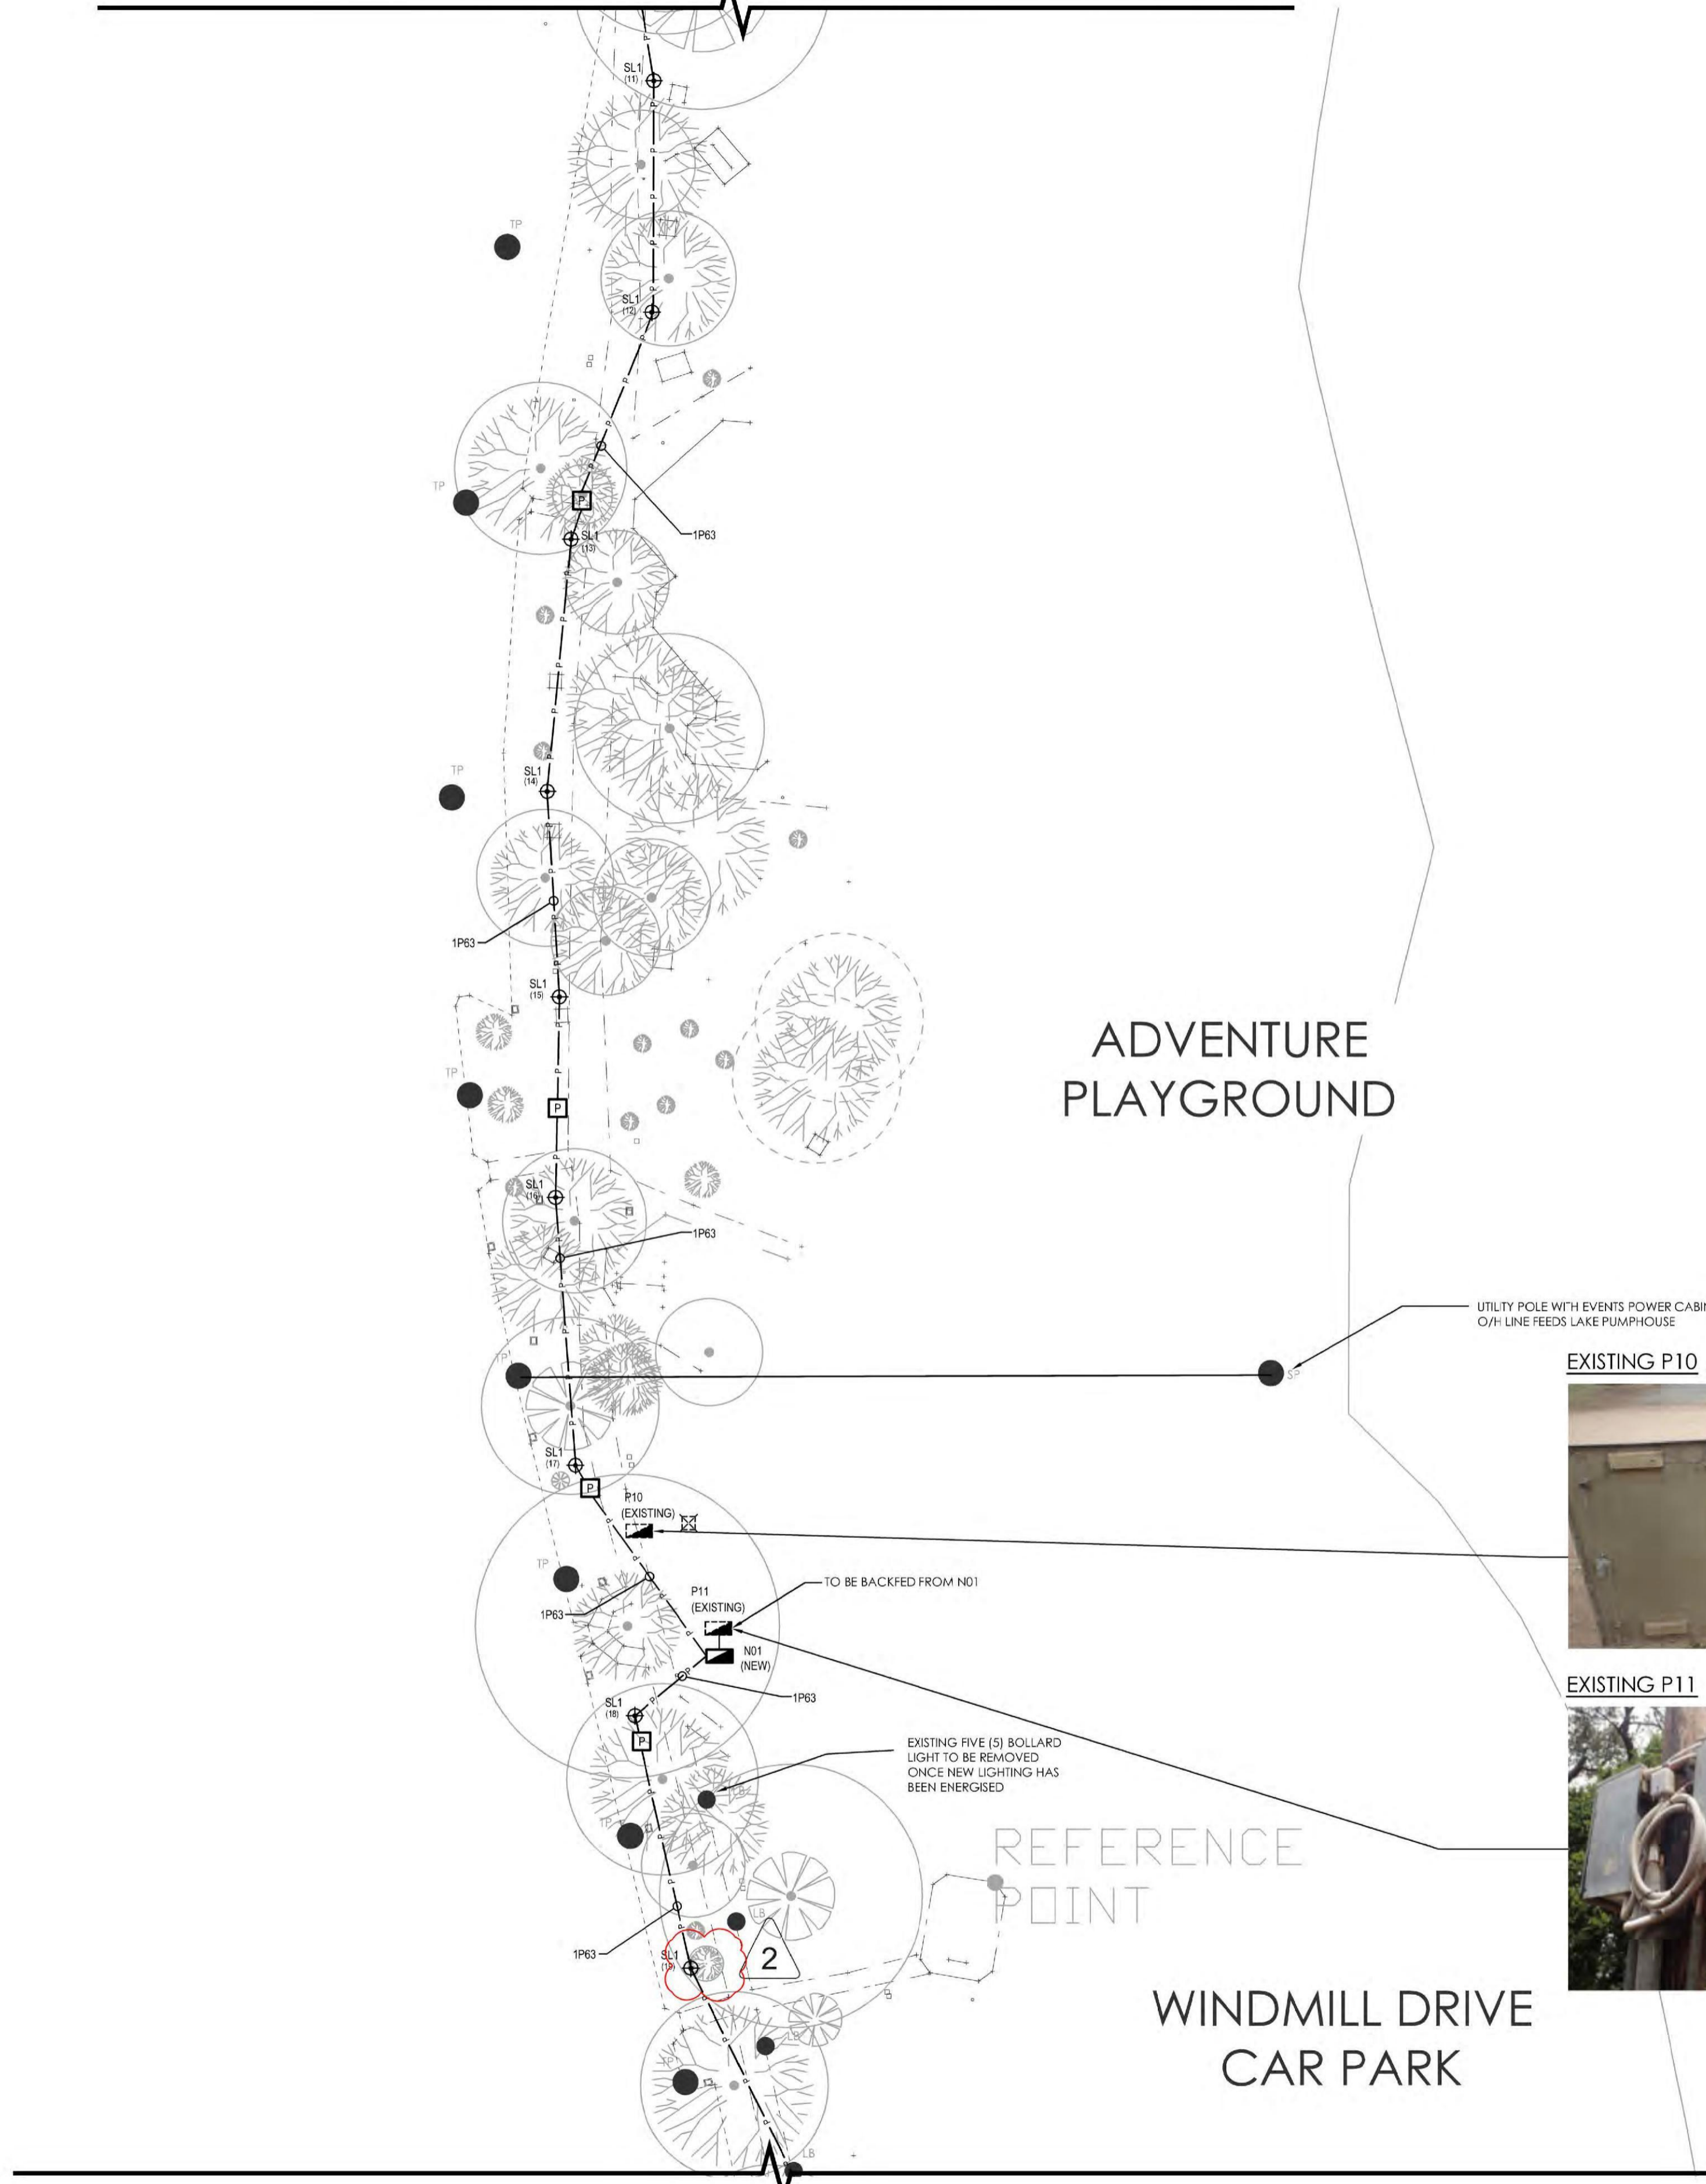

ADVENTURE PLAYGROUND

WINDMILL DRIVE CAR PARK

UTILITY POLE WITH EVENTS POWER CABINET. O/H LINE FEEDS LAKE PUMPHOUSE

EXISTING P10



EXISTING P11



REFERENCE POINT


NOTES

- THIS DRAWING SHALL BE READ IN CONJUNCTION WITH THE ELECTRICAL SERVICES SPECIFICATION NOTES, THE ARCHITECTURAL DRAWINGS AND ALL OTHER RELEVANT SERVICES DRAWINGS.
- REFER TO EL-0-01 FOR LEGEND, GENERAL NOTES AND LIGHT FITTING SCHEDULE.
- POWER AND COMMUNICATION CONDUITS SHALL BE BORED. ENSURE THAT THE MINIMUM REQUIRED CLEARANCE IS MAINTAINED BETWEEN SERVICES.
- CABLE PITS WITHIN PATHWAYS SHALL BE FINISHED FLUSH WITH THE FINISHED LEVEL OF THE IN-SITU CONCRETE, PAVING OR BITUMEN.
- ALL CONDUITS SHALL BE SEALED TO PREVENT THE INGRESS OF WATER AFTER INSTALLATION OF CABLING.
- ALL EQUIPMENT AND ACCESSORIES SHALL BE NEW UNLESS NOTED OTHERWISE.
- THE ELECTRICAL EQUIPMENT SHOWN ON THE DRAWINGS ARE NOT TO SCALE. FINAL POSITION OF ALL EQUIPMENT TO BE DETERMINED ON SITE PRIOR TO INSTALLATION. REFER TO ARCHITECTURAL FITOUT DRAWINGS.
- CONDUIT SIZE SHOWN IS REPRESENTATIVE OF THE MINIMUM REQUIREMENT. THE CONTRACTOR MUST SIZE UP TO SUIT THE FINAL CABLE SIZE.
- CONTRACTOR SHALL ENGAGE WITH TREE ARBORIST TO VALIDATE TPZ (TREE PROTECTION ZONES) WHERE CONDUITS ARE INSTALLED IN CLOSE PROXIMITY AND ADEQUATE PROTECTION SHALL BE PROVIDED TO PREVENT UNDUO DAMAGE TO CONDUITS. EXACT FINAL CONDUIT ROUTES WOULD BE SUBJECT TO SATISFYING ARBORIST REQUIREMENTS.
- CONTRACTOR SHALL RUN CONDUIT CLOSE TO PATHWAY EDGE. THE CONDUIT RUN DRAWN HERE IS ONLY INDICATIVE. CONTRACTOR TO CONSIDER 500mm BACK OF PATH IN ADDITION TO ABOVE.
- PROJECT ARBORIST WILL REVIEW ONSITE ALL NEW POLE LOCATIONS SHOWN. DIRECTIONAL BORING FOR UNDERGROUND CONDUITS IS TO OCCUR AT 100MM DEPTH.

2

HERITAGE VICTORIA HERITAGE VICTORIA HERITAGE
 Permit No. P33955
 09/09/2022
 UNDERGROUND SERVICES NOTES
 VHR No. H2252
 Page 17 of 26
 FILE No. -
 Executive Director
 NOTE: Conditions apply.

WARNING
 BEWARE OF NEW AND EXISTING UNDERGROUND SERVICES
 THE LOCATIONS OF NEW AND EXISTING UNDERGROUND SERVICES ARE APPROXIMATE ONLY AND THEIR EXACT POSITION SHOULD BE PROVEN ON SITE. NO GUARANTEE IS GIVEN THAT ALL EXISTING SERVICES ARE SHOWN. IT IS THE CONTRACTORS RESPONSIBILITY TO VERIFY LOCATION AND DEPTH OF ALL NEW AND EXISTING UNDERGROUND SERVICES PRIOR TO CONSTRUCTION WORK. THE CONTRACTOR SHALL VISIT THE SITE TO ASCERTAIN THE TRUE NATURE OF THE WORKS. NO CLAIMS FOR EXTRAS WILL BE ALLOWED FOR THROUGH NEGLECT OF THIS ADVICE. COORDINATE INVERT LEVEL AND LOCATION OF NEW AND EXISTING SERVICES TO AVOID CLASHES WITH STRUCTURAL ELEMENTS AND OTHER SERVICES OF OTHER TRADES BEFORE COMMENCING ANY WORK ON SITE.

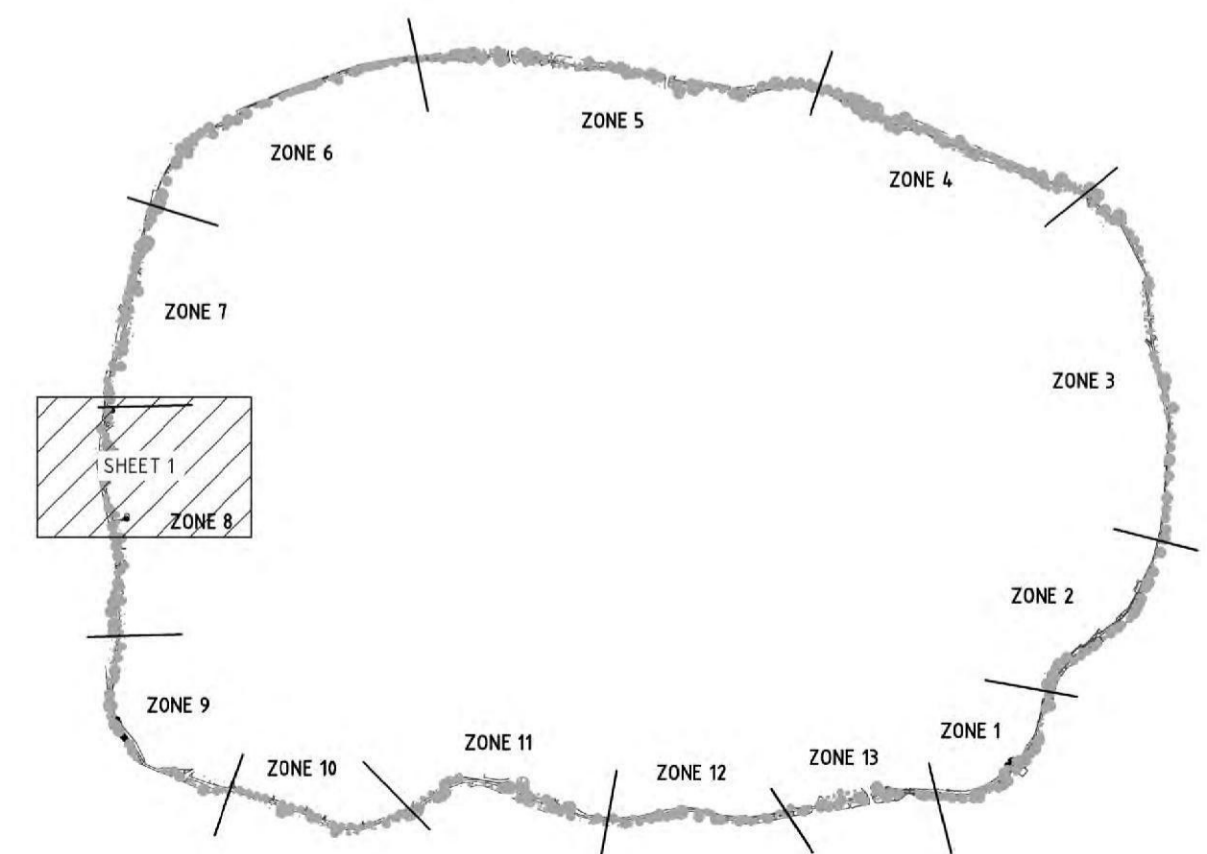

KEY PLAN

FOR CONTINUATION REFER TO DRAWING EL-2-15 (ZONE 8 - SHEET 2)

REV	DESCRIPTION	DRAWN	APPD	DATE
2	ISSUED FOR CONSTRUCTION	TRS	JPK	07.06.22
1	ISSUED FOR CONSTRUCTION	TRS	JPK	13.04.22

REPRODUCTION OF DRAWINGS
 THE DRAWINGS HAVE BEEN DOCUMENTED IN COLOUR. AS SUCH, THE DRAWINGS ARE REQUIRED TO BE PRINTED IN COLOUR. FAILURE TO DO SO MAY RESULT IN LOSS OF INFORMATION. BLACK & WHITE PRINTING MAY BE USED IF SPECIFIC BLACK & WHITE DOCUMENTS HAVE BEEN OBTAINED FROM WGE.

CITY OF BALLARAT

ARCHITECT/CIENT

LAKE WENDOUREE, BALLARAT, STEVE MONEGHETTI TRACK PUBLIC LIGHTING

ZONE 8 - PROPOSED LIGHTING & POWER LAYOUT - STAGE 3 SHEET 1

PROJECT TITLE

45683-EL-2-4.dwg

CONSTRUCTION ISSUE

Stantec

ELECTRICAL SERVICES


1:500 45683 EL-2-14 2

SCALE @ A1 PROJECT No DRAWING No REV

7/06/2022 5:30:39 PM

DB	POLES	CIRCUIT
ND1	10	L1
ND1	11	L1
ND1	12	L1
ND1	13	L1
ND1	14	L1
ND1	15	L1
ND1	16	L1
ND1	17	L1
ND1	18	L2
ND1	19	L2
ND1	20	L2
ND1	21	L2
ND1	22	L2
ND1	22-1	L2

DB	POLES	CIRCUIT
P12	23	L14
P12	24	L14
P12	25	L14
P12	26	L14
P12	27	L14

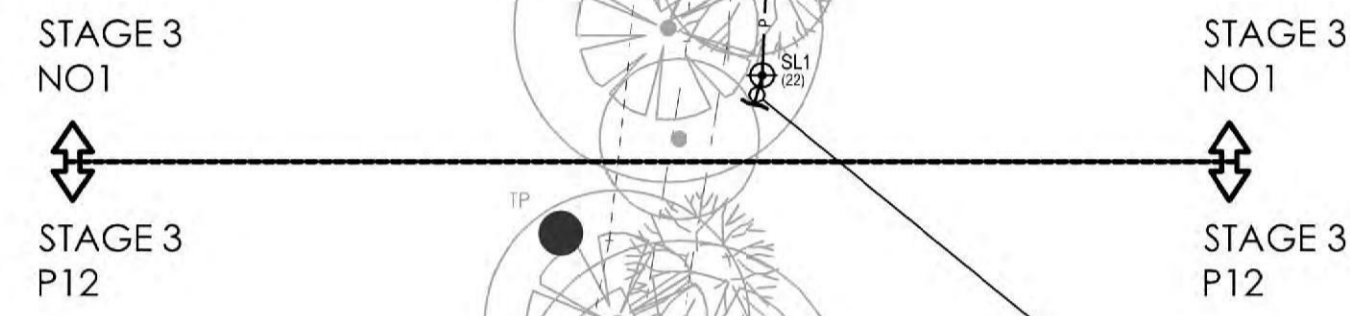

INDIGENOUS PLAYGROUND


NOTES

- THIS DRAWING SHALL BE READ IN CONJUNCTION WITH THE ELECTRICAL SERVICES SPECIFICATION NOTES, THE ARCHITECTURAL DRAWINGS AND ALL OTHER RELEVANT SERVICES DRAWINGS.
- REFER TO EL-2-14 FOR LEGEND, GENERAL NOTES AND LIGHT FITTING SCHEDULE.
- WHERE POSSIBLE, ALL POWER AND COMMUNICATION CONDUITS SHALL BE INSTALLED IN COMMON TRENCHES WITH THE OTHER SERVICES TRADES. ENSURE THAT THE MINIMUM REQUIRED CLEARANCE IS MAINTAINED BETWEEN SERVICES THAT RUN IN COMMON TRENCHES.
- CABLE PITS WITHIN PATHWAYS SHALL BE FINISHED FLUSH WITH THE FINISHED LEVEL OF THE INSITU CONCRETE, PAVING OR BITUMEN.
- ALL CONDUITS SHALL BE SEALED TO PREVENT THE INGRESS OF WATER AFTER INSTALLATION OF CABLING.
- ALL EQUIPMENT AND ACCESSORIES SHALL BE NEW UNLESS NOTED OTHERWISE.
- THE ELECTRICAL EQUIPMENT SHOWN ON THE DRAWINGS ARE NOT TO SCALE. FINAL POSITION OF ALL EQUIPMENT TO BE DETERMINED ON SITE PRIOR TO INSTALLATION. REFER TO ARCHITECTURAL FITOUT DRAWINGS.
- CONDUIT SIZE SHOWN IS REPRESENTATIVE OF THE MINIMUM REQUIREMENT. THE CONTRACTOR MUST SIZE UP TO SUIT THE FINAL CABLE SIZE.
- CONTRACTOR SHALL ENGAGE WITH TREE ARBORIST TO VALIDATE TPZ (TREE PROTECTION ZONES) WHERE CONDUITS ARE INSTALLED IN CLOSE PROXIMITY AND ADEQUATE PROTECTION SHALL BE PROVIDED TO PREVENT UNDUE DAMAGE TO CONDUITS. EXACT FINAL CONDUIT ROUTES WOULD BE SUBJECT TO SATISFYING ARBORIST REQUIREMENTS.
- CONTRACTOR SHALL RUN CONDUIT CLOSE TO PATHWAY EDGE. THE CONDUIT RUN DRAWN HERE IS ONLY INDICATIVE. CONTRACTOR TO CONSIDER 500mm BACK OF PATH IN ADDITION TO ABOVE.
- PROJECT ARBORIST WILL REVIEW ONSITE ALL NEW POLE LOCATIONS SHOWN. DIRECTIONAL BORING FOR UNDERGROUND CONDUITS IS TO OCCUR AT 1000MM DEPTH.

2

HERITAGE VICTORIA HERITAGE VICTORIA HERITAGE VICTORIA
 Permit No. P33955
 09/09/2022
 VHR No. H2252
 File No. -
 Page 18 of 26
 Executive Director
 NOTE: Conditions apply.

WARNING
 BEWARE OF NEW AND EXISTING UNDERGROUND SERVICES
 THE LOCATIONS OF NEW AND EXISTING UNDERGROUND SERVICES ARE APPROXIMATE ONLY AND THEIR EXACT POSITION SHOULD BE PROVEN ON SITE. NO GUARANTEE IS GIVEN THAT ALL EXISTING SERVICES ARE SHOWN. IT IS THE CONTRACTORS RESPONSIBILITY TO VERIFY LOCATION AND DEPTH OF ALL NEW AND EXISTING UNDERGROUND SERVICES PRIOR TO CONSTRUCTION WORK. THE CONTRACTOR SHALL VISIT THE SITE TO ASCERTAIN THE TRUE NATURE OF THE WORKS. NO CLAIMS FOR EXTRAS WILL BE ALLOWED FOR THROUGH NEGLIGENCE OF THIS ADVICE. COORDINATE INVERT LEVEL AND LOCATION OF NEW AND EXISTING SERVICES TO AVOID CLASHES WITH STRUCTURAL ELEMENTS AND OTHER SERVICES OF OTHER TRADES BEFORE COMMENCING ANY WORK ON SITE.

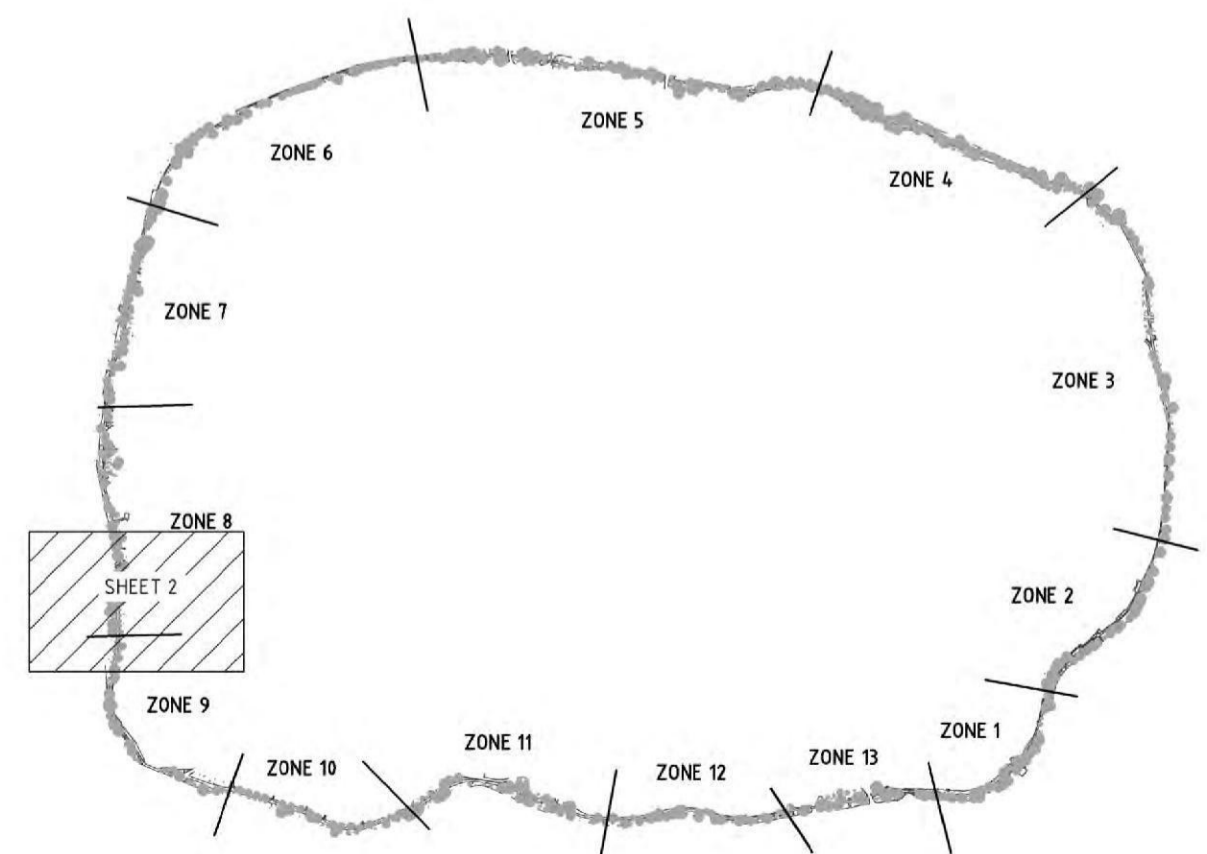

KEY PLAN

REV	DESCRIPTION	DRAWN	APPD	DATE
2	ISSUED FOR CONSTRUCTION	TRS	JPK	07.06.22
1	ISSUED FOR CONSTRUCTION	TRS	JPK	13.04.22

THE DRAWINGS HAVE BEEN DOCUMENTED IN COLOUR. AS SUCH, THE DRAWINGS ARE REQUIRED TO BE PRINTED IN COLOUR. FAILURE TO DO SO MAY RESULT IN LOSS OF INFORMATION. BLACK & WHITE PRINTING MAY BE USED IF SPECIFIC BLACK & WHITE DOCUMENTS HAVE BEEN OBTAINED FROM WGE.

CITY OF BALLARAT

ARCHITECT/CIENT

LAKE WENDOUREE, BALLARAT, STEVE MONEGHETTI TRACK PUBLIC LIGHTING

PROJECT

TITLE

45683-EL-2-15.dwg

7/06/2022 5:01:59 PM

CONSTRUCTION ISSUE

Stantec

ELECTRICAL SERVICES

1:500 45683 EL-2-15 2


SCALE @ A1 PROJECT No DRAWING No REV

NOTES

- THIS DRAWING SHALL BE READ IN CONJUNCTION WITH THE ELECTRICAL SERVICES SPECIFICATION NOTES, THE ARCHITECTURAL DRAWINGS AND ALL OTHER RELEVANT SERVICES DRAWINGS.
- REFER TO EL-0-01 FOR LEGEND, GENERAL NOTES AND LIGHT FITTING SCHEDULE.
- POWER AND COMMUNICATION CONDUITS SHALL BE BORED. ENSURE THAT THE MINIMUM REQUIRED CLEARANCE IS MAINTAINED BETWEEN SERVICES.
- CABLE PTS WITHIN PATHWAYS SHALL BE FINISHED FLUSH WITH THE FINISHED LEVEL OF THE INSTU CONCRETE, PAVING OR BITUMEN.
- ALL CONDUITS SHALL BE SEALED TO PREVENT THE INGRESS OF WATER AFTER INSTALLATION OF CABLING.
- ALL EQUIPMENT AND ACCESSORIES SHALL BE NEW UNLESS NOTED OTHERWISE.
- THE ELECTRICAL EQUIPMENT SHOWN ON THE DRAWINGS ARE NOT TO SCALE. FINAL POSITION OF ALL EQUIPMENT TO BE DETERMINED ON SITE PRIOR TO INSTALLATION. REFER TO ARCHITECTURAL FITOUT DRAWINGS.
- CONDUIT SIZE SHOWN IS REPRESENTATIVE OF THE MINIMUM REQUIREMENT. THE CONTRACTOR MUST SIZE UP TO SUIT THE FINAL CABLE SIZE.
- CONTRACTOR SHALL ENGAGE WITH TREE ARBORIST TO VALIDATE TPZ (TREE PROTECTION ZONES) WHERE CONDUITS ARE INSTALLED IN CLOSE PROXIMITY AND ADEQUATE PROTECTION SHALL BE PROVIDED TO PREVENT UNDEE DAMAGE TO CONDUITS. EXACT FINAL CONDUIT ROUTES WOULD BE SUBJECT TO SATISFYING ARBORIST REQUIREMENTS.
- CONTRACTOR SHALL RUN CONDUIT CLOSE TO PATHWAY EDGE. THE CONDUIT RUN DRAWN HERE IS ONLY INDICATIVE. CONTRACTOR TO CONSIDER 500mm BACK OF PATH IN ADDITION TO ABOVE.
- PROJECT ARBORIST WILL REVIEW ONSITE ALL NEW POLE LOCATIONS SHOWN. DIRECTIONAL BORING FOR UNDERGROUND CONDUITS IS TO OCCUR AT 1000MM DEPTH.

DB	POLES	CIRCUIT	DB	POLES	CIRCUIT
P13	27	L1	P14	35	L1
P13	28	L1	P14	36	L1
P13	29	L1	P14	37	L1
P13	30	L1	P14	38	L1
P13	31	L1	P14	39	L1
P13	32	L1	P14	40	L22
P13	33	L1	P14	41	L22
P13	34	L1	P14	42	L22
			P14	43	L22
			P14	44	L22
			P14	45	L22
			P14	46	L22
			P14	47	L22
			P14	48	L22
			P14	49	L22
			P14	50	L22

EXISTING P13

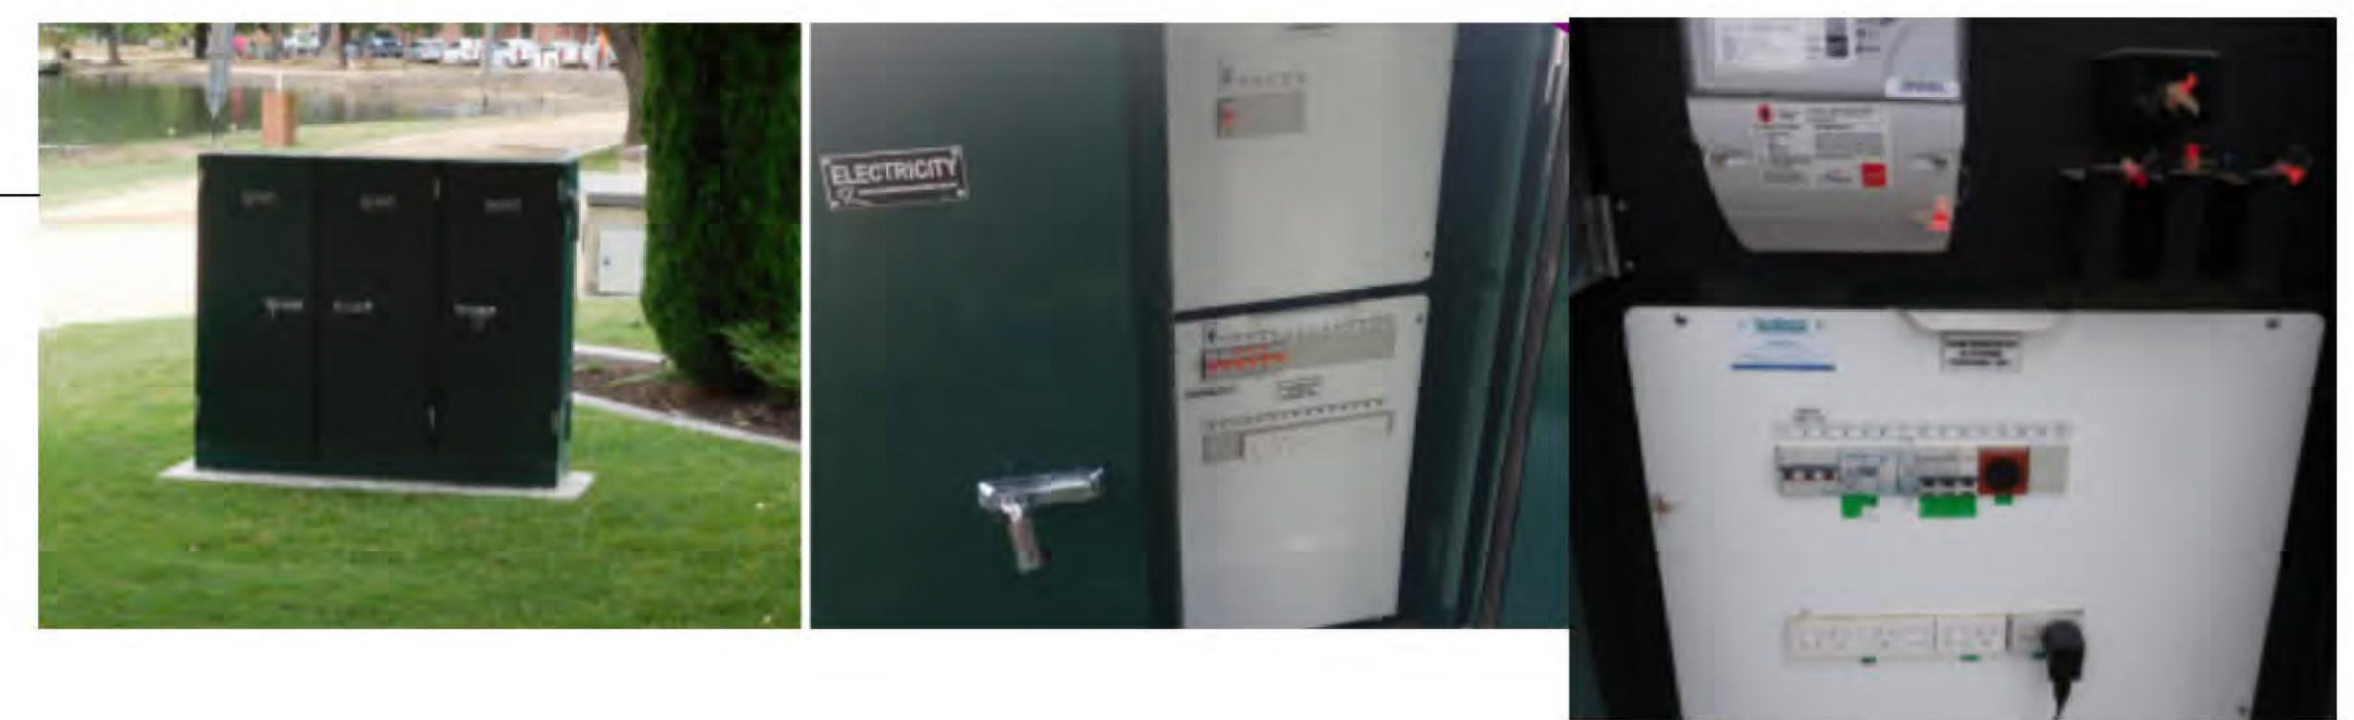


EXISTING P14




BALLARAT 1956 OLYMPIC VENUE MEMORIAL

LAKE WENDO ROWING OBSER

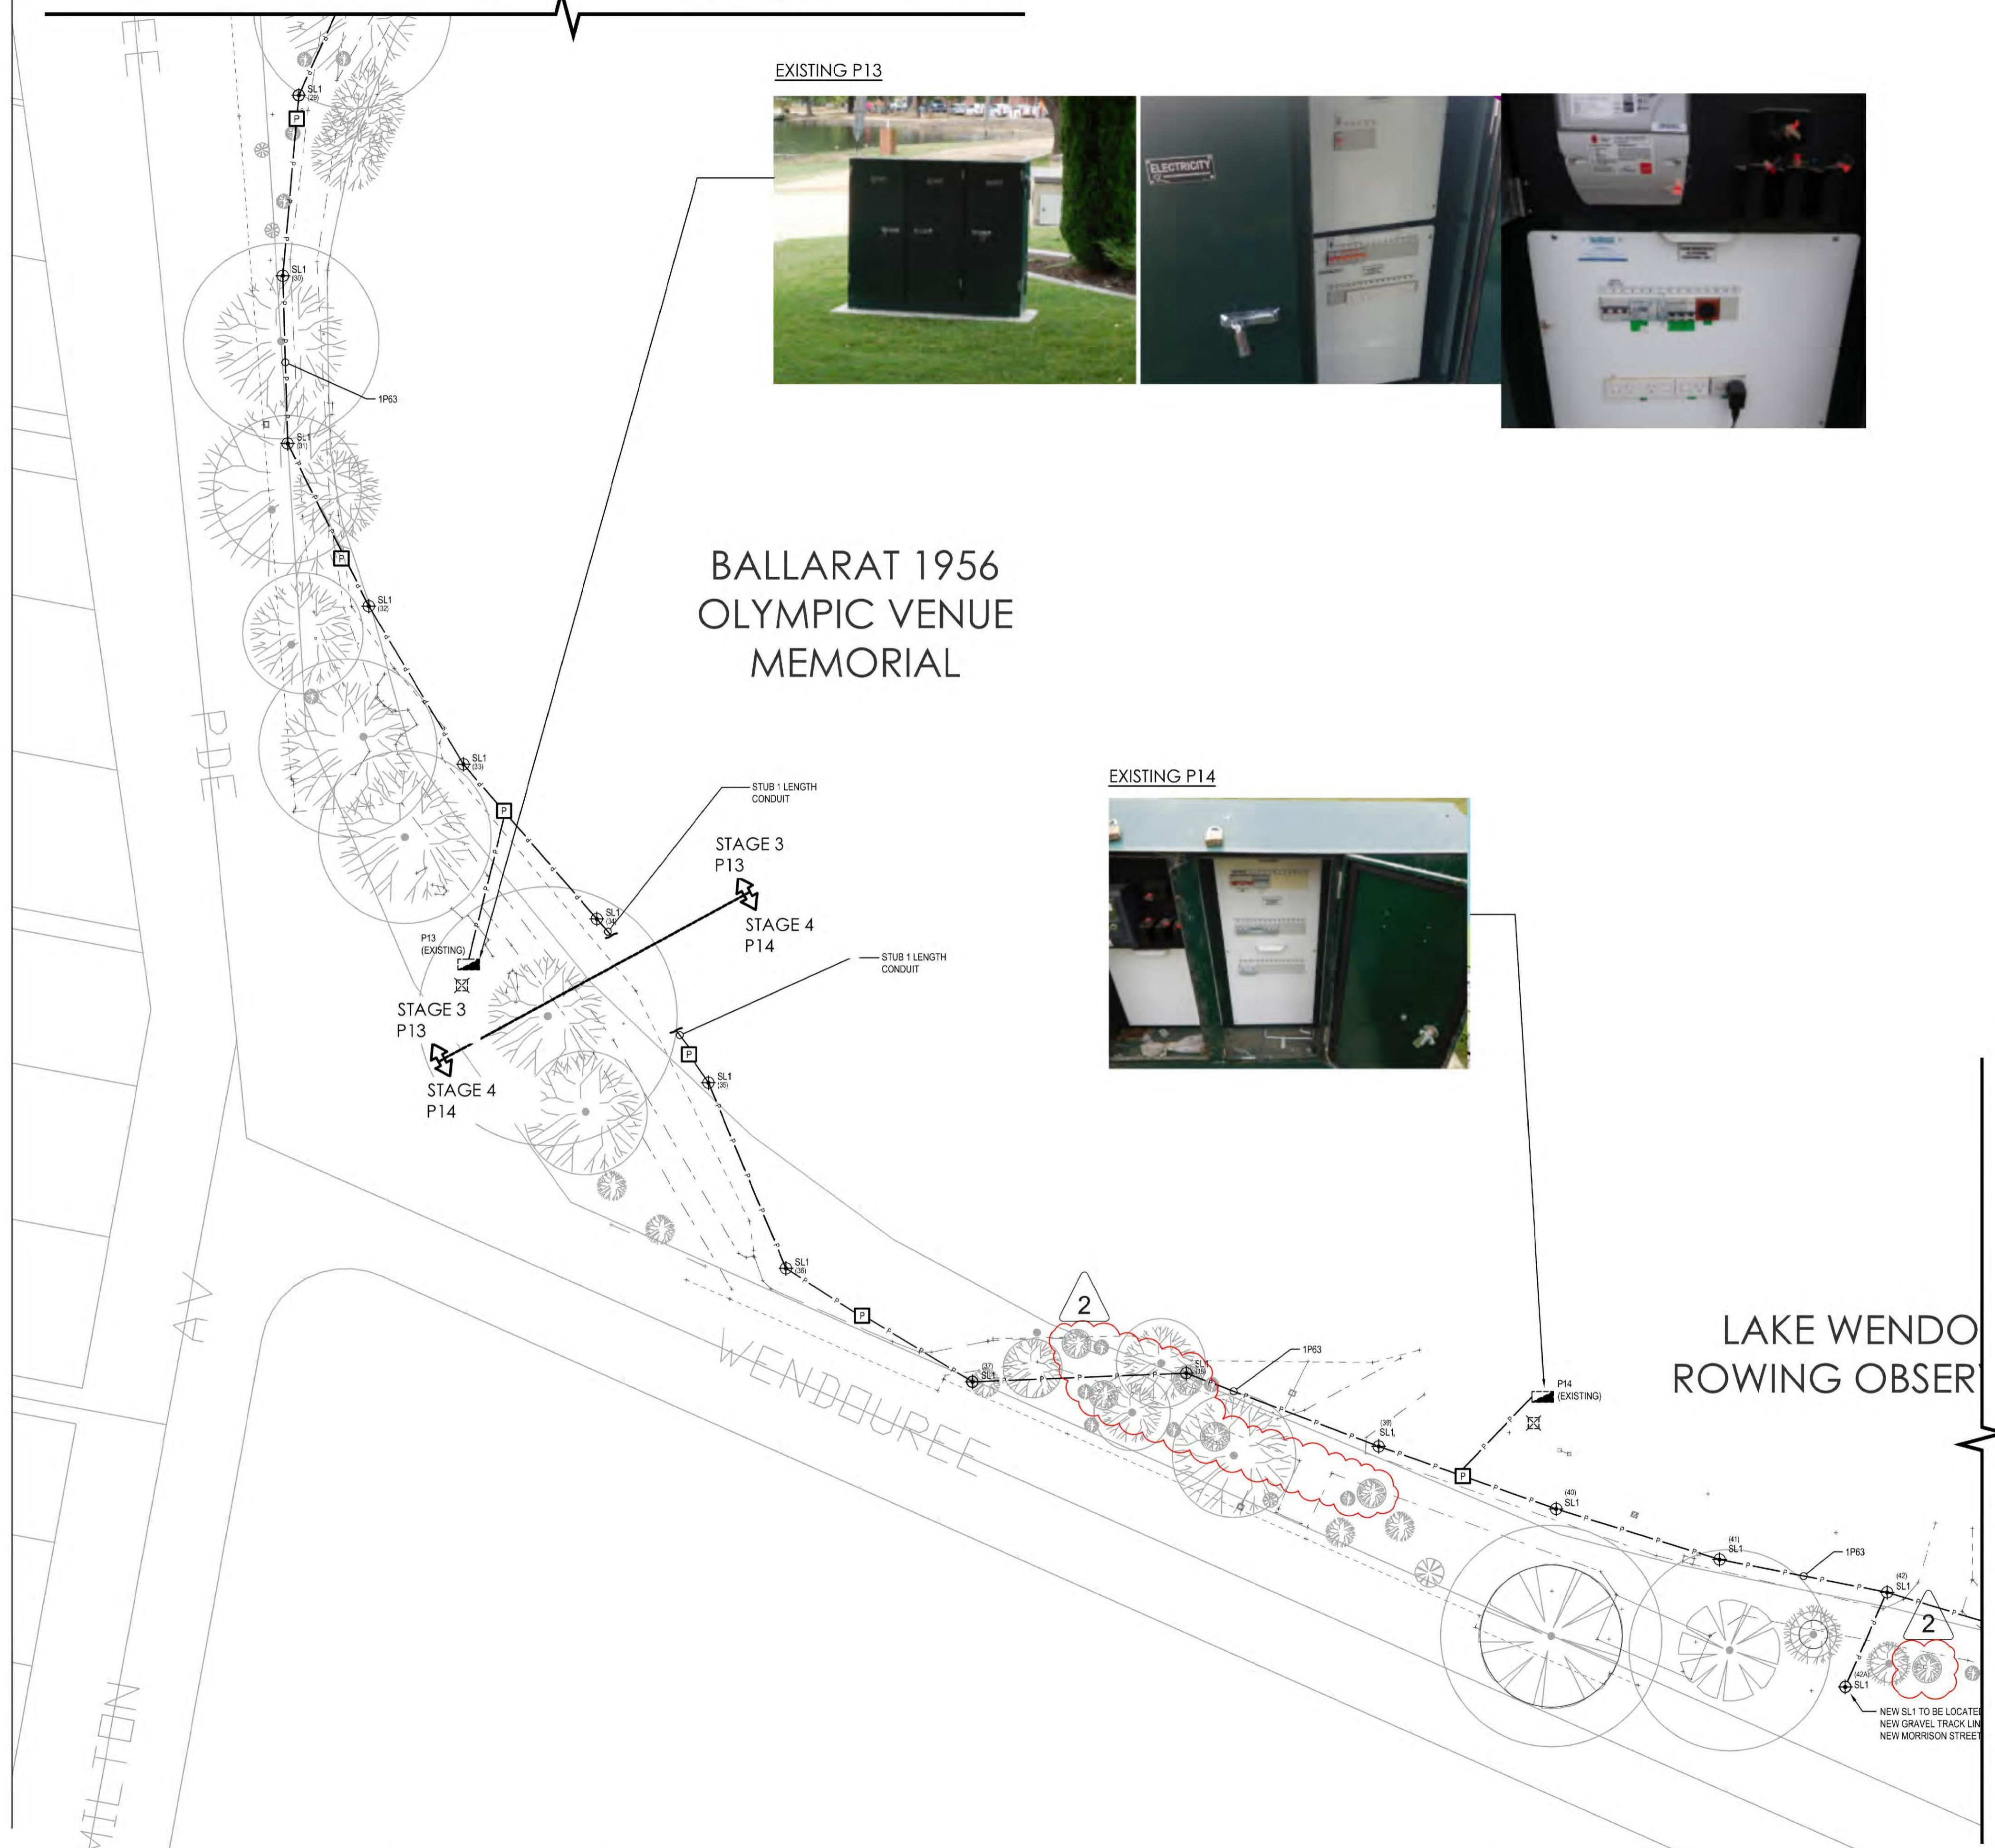

FOR CONTINUATION REFER TO DRAWING EL-2-17 (ZONE 10 - SHEET 1)

WARNING
 BEWARE OF NEW AND EXISTING UNDERGROUND SERVICES
 THE LOCATIONS OF NEW AND EXISTING UNDERGROUND SERVICES ARE APPROXIMATE ONLY AND THEIR EXACT POSITION SHOULD BE PROVEN ON SITE. NO GUARANTEE IS GIVEN THAT ALL EXISTING SERVICES ARE SHOWN. IT IS THE CONTRACTORS RESPONSIBILITY TO VERIFY LOCATION AND DEPTH OF ALL NEW AND EXISTING UNDERGROUND SERVICES PRIOR TO CONSTRUCTION WORK. THE CONTRACTOR SHALL VISIT THE SITE TO ASCERTAIN THE TRUE NATURE OF THE WORKS. NO CLAIMS FOR EXTRAS WILL BE ALLOWED FOR THROUGH NEGLIGENCE OF THIS ADVICE. COORDINATE INVERT LEVEL AND LOCATION OF NEW AND EXISTING SERVICES TO AVOID CLASHES WITH STRUCTURAL ELEMENTS AND OTHER SERVICES OF OTHER TRADES BEFORE COMMENCING ANY WORK ON SITE.

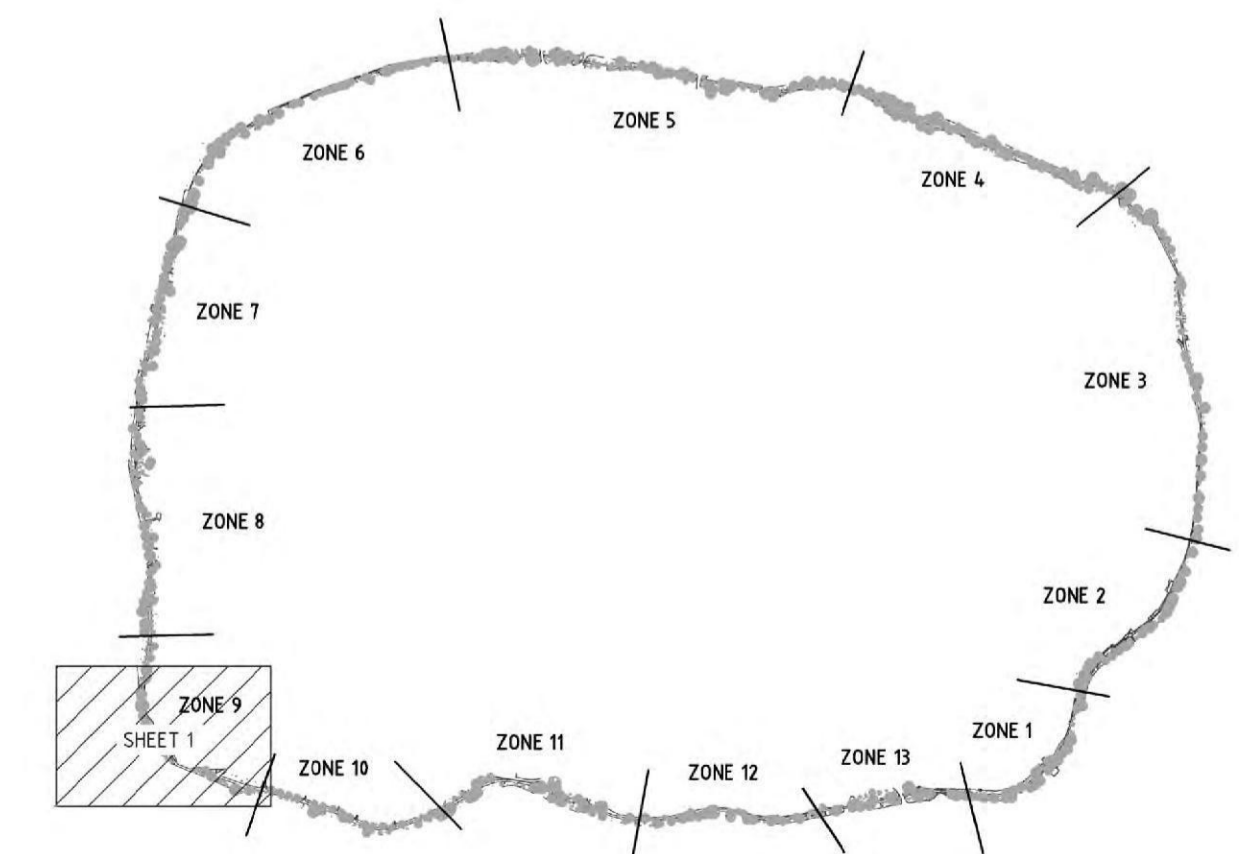

KEY PLAN

REV	DESCRIPTION	DRAWN	APPD	DATE
2	ISSUED FOR CONSTRUCTION	TRS	JPK	07.06.22
1	ISSUED FOR CONSTRUCTION	TRS	JPK	24.03.22

REPRODUCTION OF DRAWINGS
 THE DRAWINGS HAVE BEEN DOCUMENTED IN COLOUR. AS SUCH, THE DRAWINGS ARE REQUIRED TO BE PRINTED IN COLOUR. FAILURE TO DO SO MAY RESULT IN LOSS OF INFORMATION. BLACK & WHITE PRINTING MAY BE USED IF SPECIFIC BLACK & WHITE DOCUMENTS HAVE BEEN OBTAINED FROM WGE.

CITY OF BALLARAT

ARCHITECT/CIENT

LAKE WENDOUREE, BALLARAT, STEVE MONEGHETTI TRACK PUBLIC LIGHTING

PROJECT

ZONE 9 - PROPOSED LIGHTING & POWER LAYOUT - STAGE 3 & STAGE 4 SHEET 1

TITLE

CONSTRUCTION ISSUE

Stantec

ELECTRICAL SERVICES

1:500 45683 EL-2-16 2

SCALE @ A1 PROJECT No DRAWING No REV

FOR CONTINUATION REFER TO DRAWING EL-2-16 (ZONE 9 - SHEET 1)

LAKE WENDOUREE ROWING OBSERVATION



DB	POLES	CIRCUIT
P14	35	L1
P14	36	L1
P14	37	L1
P14	38	L1
P14	39	L1
P14	40	L22
P14	41	L22
P14	42	L22
P14	43	L22
P14	44	L22
P14	45	L22
P14	46	L22
P14	47	L22
P14	48	L22
P14	49	L22
P14	50	L22

DB	POLES	CIRCUIT
N02	51	L1
N02	52	L1
N02	53	L1
N02	54	L1
N02	55	L1
N02	56	L1
N02	57	L2
N02	58	L2
N02	59	L2
N02	60	L2
N02	61	L2
N02	62	L2
N02	63	L2
N02	64	L3
N02	65	L3
N02	66	L3
N02	67	L3
N02	68	L3
N02	68	L3
N02	70	L3

NOTES

- THIS DRAWING SHALL BE READ IN CONJUNCTION WITH THE ELECTRICAL SERVICES SPECIFICATION NOTES, THE ARCHITECTURAL DRAWINGS AND ALL OTHER RELEVANT SERVICES DRAWINGS.
- REFER TO EL-0-01 FOR LEGEND, GENERAL NOTES AND LIGHT FITTING SCHEDULE.
- POWER AND COMMUNICATION CONDUITS SHALL BE BORED. ENSURE THAT THE MINIMUM REQUIRED CLEARANCE IS MAINTAINED BETWEEN SERVICES.
- CABLE PITS WITHIN PATHWAYS SHALL BE FINISHED FLUSH WITH THE FINISHED LEVEL OF THE IN-SITU CONCRETE, PAVING OR BITUMEN.
- ALL CONDUITS SHALL BE SEALED TO PREVENT THE INGRESS OF WATER AFTER INSTALLATION OF CABLING.
- ALL EQUIPMENT AND ACCESSORIES SHALL BE NEW UNLESS NOTED OTHERWISE.
- THE ELECTRICAL EQUIPMENT SHOWN ON THE DRAWINGS ARE NOT TO SCALE. FINAL POSITION OF ALL EQUIPMENT TO BE DETERMINED ON SITE PRIOR TO INSTALLATION. REFER TO ARCHITECTURAL FITOUT DRAWINGS.
- CONDUIT SIZE SHOWN IS REPRESENTATIVE OF THE MINIMUM REQUIREMENT. THE CONTRACTOR MUST SIZE UP TO SUIT THE FINAL CABLE SIZE.
- CONTRACTOR SHALL ENGAGE WITH TREE ARBORIST TO VALIDATE TPZ (TREE PROTECTION ZONES) WHERE CONDUITS ARE INSTALLED IN CLOSE PROXIMITY AND ADEQUATE PROTECTION SHALL BE PROVIDED TO PREVENT UNDUPLICATE DAMAGE TO CONDUITS. EXACT FINAL CONDUIT ROUTES WOULD BE SUBJECT TO SATISFYING ARBORIST REQUIREMENTS.
- CONTRACTOR SHALL RUN CONDUIT CLOSE TO PATHWAY EDGE. THE CONDUIT RUN DRAWN HERE IS ONLY INDICATIVE. CONTRACTOR TO CONSIDER 500mm BACK OF PATH IN ADDITION TO ABOVE.
- PROJECT ARBORIST WILL REVIEW ON-SITE ALL NEW POLE LOCATIONS SHOWN. DIRECTIONAL BORING FOR UNDERGROUND CONDUITS IS TO OCCUR AT 100MM DEPTH.

HERITAGE VICTORIA HERITAGE VICTORIA HERITAGE
 ENDORSED DOCUMENT
 Permit No. P33955
 09/09/2022
 VHR No. H2252
 UNDERGROUND SERVICES NOTES
 Page 20 of 26
 FILE No. -
 NOTE: Conditions apply.

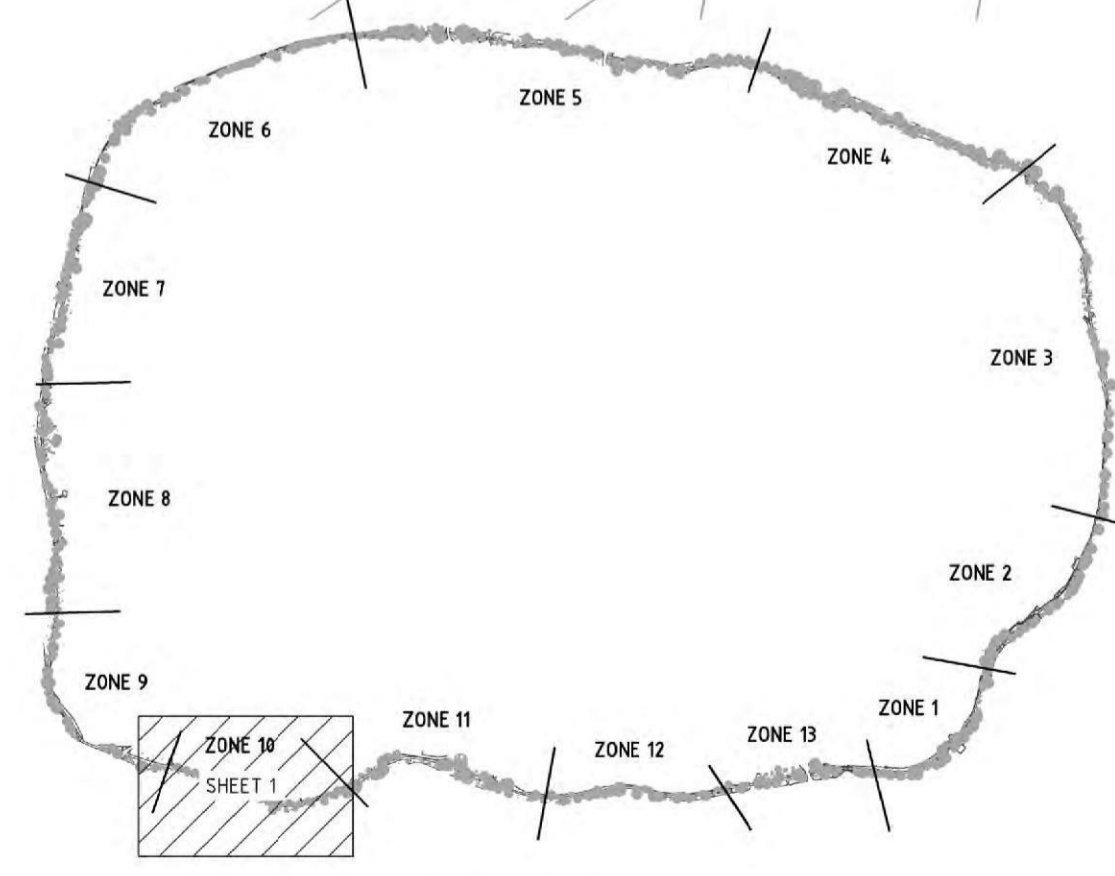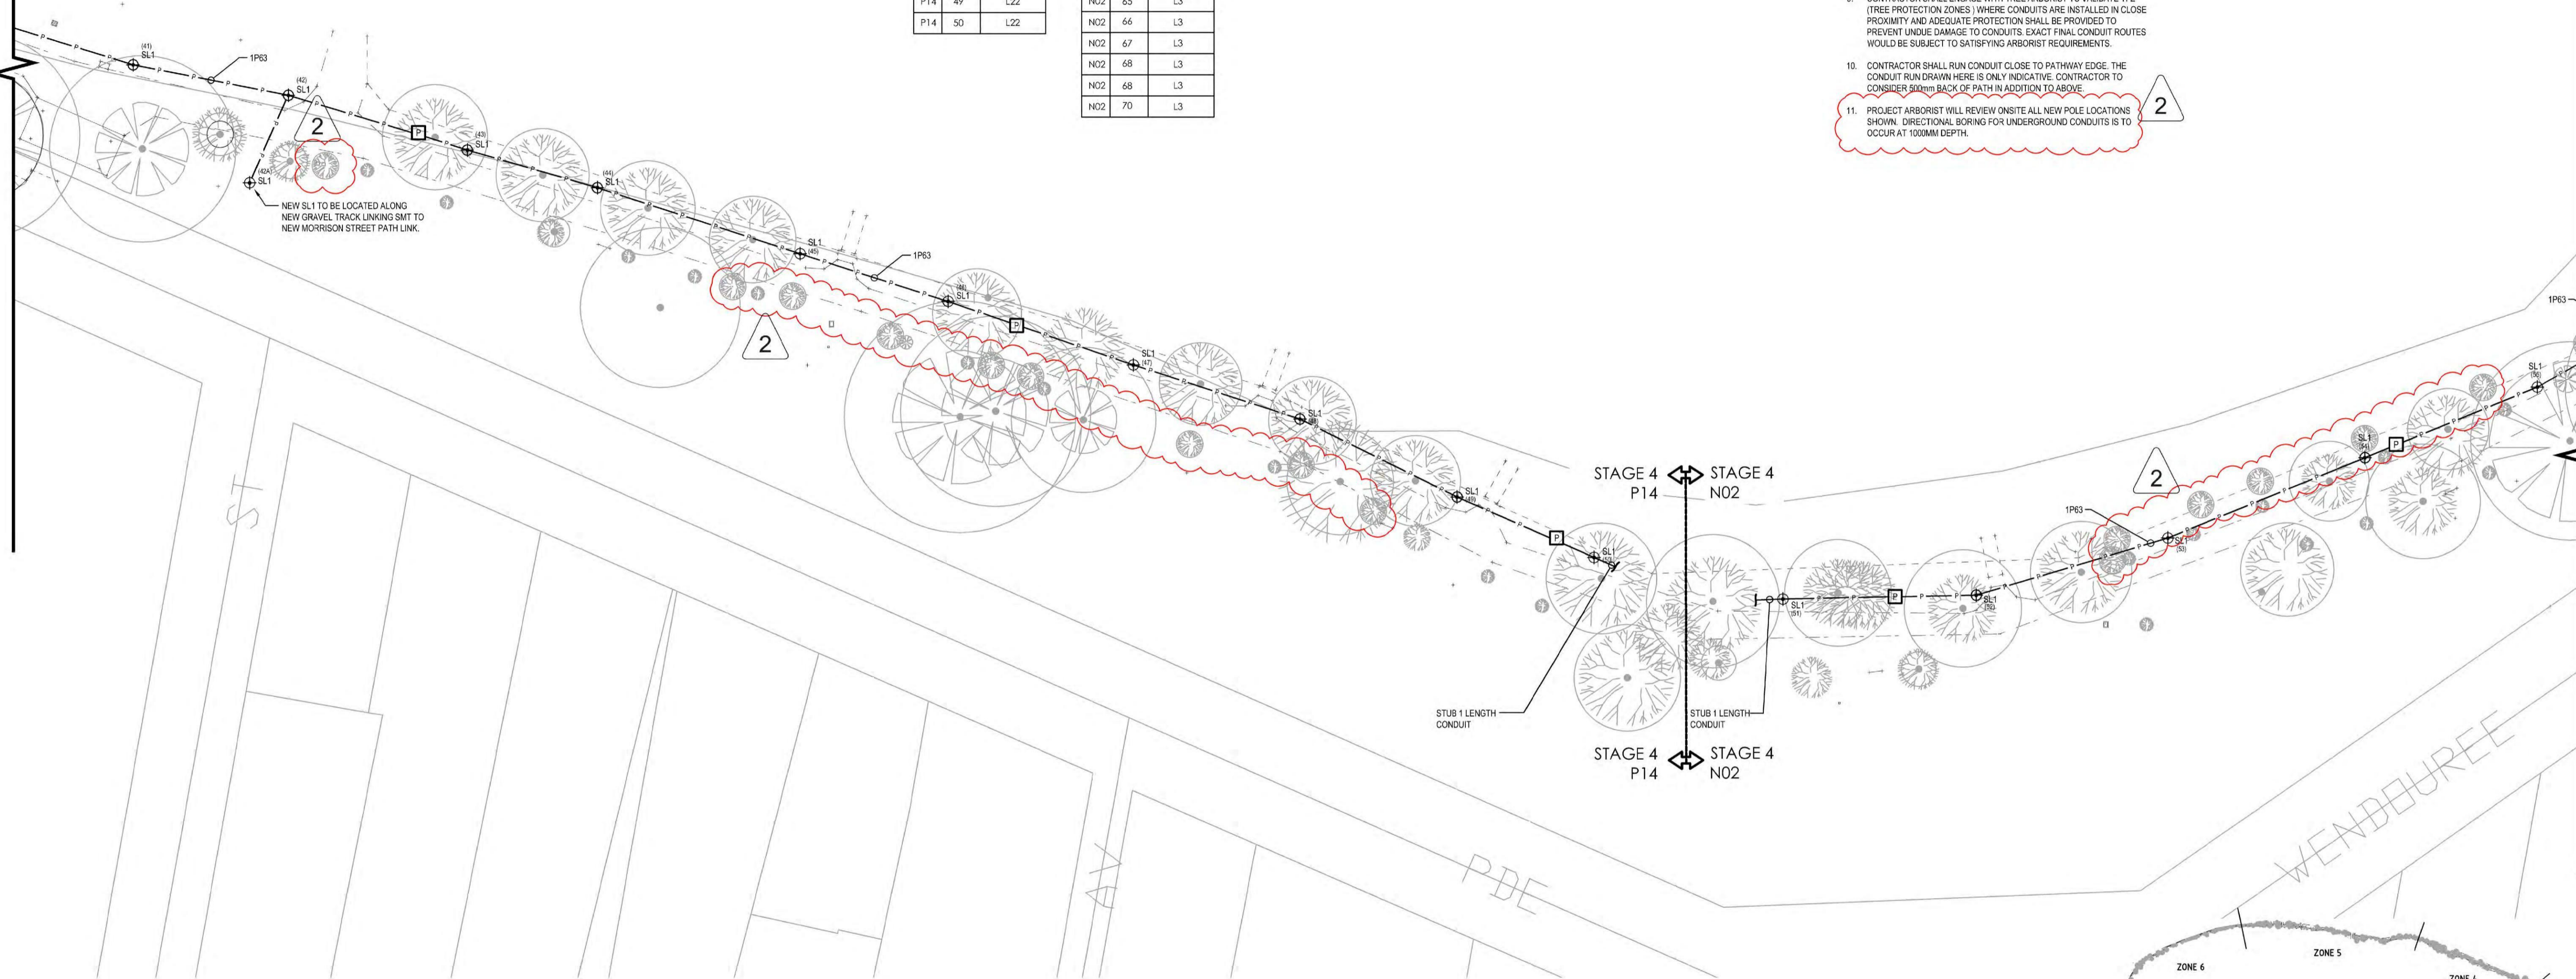

KEY PLAN

WARNING
 BEWARE OF NEW AND EXISTING UNDERGROUND SERVICES

THE LOCATIONS OF NEW AND EXISTING UNDERGROUND SERVICES ARE APPROXIMATE ONLY AND THEIR EXACT POSITION SHOULD BE PROVEN ON SITE. NO GUARANTEE IS GIVEN THAT ALL EXISTING SERVICES ARE SHOWN. IT IS THE CONTRACTORS RESPONSIBILITY TO VERIFY LOCATION AND DEPTH OF ALL NEW AND EXISTING UNDERGROUND SERVICES PRIOR TO CONSTRUCTION WORK. THE CONTRACTOR SHALL VISIT THE SITE TO ASCERTAIN THE TRUE NATURE OF THE WORKS. NO CLAIMS FOR EXTRAS WILL BE ALLOWED FOR THROUGH NEGLIGENCE OF THIS ADVICE. COORDINATE INVERT LEVEL AND LOCATION OF NEW AND EXISTING SERVICES TO AVOID CLASHES WITH STRUCTURAL ELEMENTS AND OTHER SERVICES OF OTHER TRADES BEFORE COMMENCING ANY WORK ON SITE.

REPRODUCTION OF DRAWINGS
 THE DRAWINGS HAVE BEEN DOCUMENTED IN COLOUR. AS SUCH, THE DRAWINGS ARE REQUIRED TO BE PRINTED IN COLOUR. FAILURE TO DO SO MAY RESULT IN LOSS OF INFORMATION. BLACK & WHITE PRINTING MAY BE USED IF SPECIFIC BLACK & WHITE DOCUMENTS HAVE BEEN OBTAINED FROM WGE.

CITY OF BALLARAT

ARCHITECT/CIENT

LAKE WENDOUREE, BALLARAT, STEVE MONEGHETTI TRACK PUBLIC LIGHTING

ZONE 10 - PROPOSED LIGHTING & POWER LAYOUT - STAGE 4 SHEET 1

PROJECT TITLE

45683-EL-2-7.dwg

CONSTRUCTION ISSUE

Stantec

ELECTRICAL SERVICES

1:500 45683 EL-2-17 2

SCALE @ A1 PROJECT No DRAWING No REV

7/06/2022 5:34:35 PM

REV	DESCRIPTION	DRAWN	APPD	DATE
2	ISSUED FOR CONSTRUCTION	TRS	JKP	07.06.22
1	ISSUED FOR CONSTRUCTION	TRS	JKP	13.04.22